


KANSAS

Section 26 Township 16 Range 10-W

Well No. #3 ⁴ Wamhoff ^(KGS DRILL)

Company Benson Drilling Company

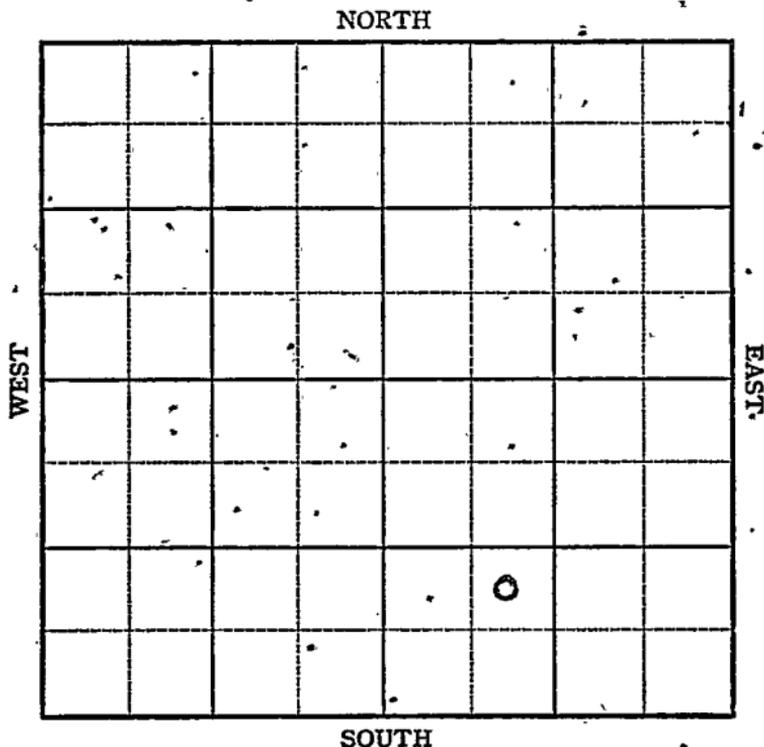

KANSAS

Ellsworth county

Sec. 26 Twp. 16 R. 10-W

Well No. #24 Wamhoff (K63 DRL) Farm _____


Benson Drlg. Company _____ Company
Bloomer Pool

_____ Ft. from N. Line

990' Ft. from S. Line

_____ Ft. from E. Line

990' Ft. from W. Line

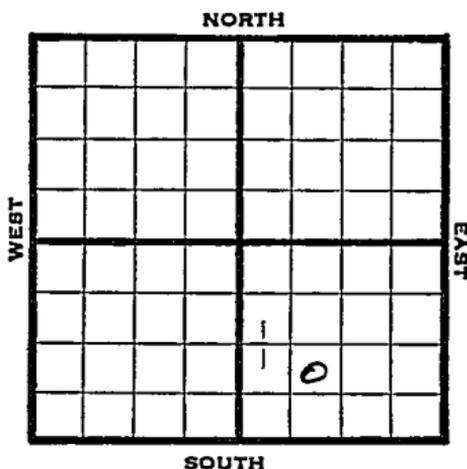

NE SW SE

REPORT	
1946	Elev. '1851'
12/4	10" @ 358' WOC
12/10	Drlg 3145'
12/18	Lans 2987' Arb 3353' TD' 3365'
ABANDONED	

Map No. 55 Sec. 26 Twp. 16 R. 10W

Well No. 4 Wamhoff (KGS 10RL)

Benson Drlg. _____ Company

FIRST REPORT _____ Contractor

NE SW SE

SECTION PLAT

_____ Ft. from N. Line
 990 Ft. from S. Line
 _____ Ft. from E. Line
 990 Ft. from W. Line

		o	

Ellsworth County

Location _____
 Rig up _____

Drilling and Remarks:
 10" @ 358 WOC

RECORD

Cased _____ in., _____ ft.
 Sand _____
 Gas _____
 Oil _____
 Total Depth _____

PRODUCTION

1st 24 hrs. Nat. _____
 1st 24 hrs. after shot _____
 Gas _____ Cu. Ft.
 Dry Hole _____
 Abandoned _____

Date

DEC 4 1946 19

S. J. LEWIS Scout

