


Section 27 Township 16 Range 10-W

Well No. #1 Schroeder

Company Texas

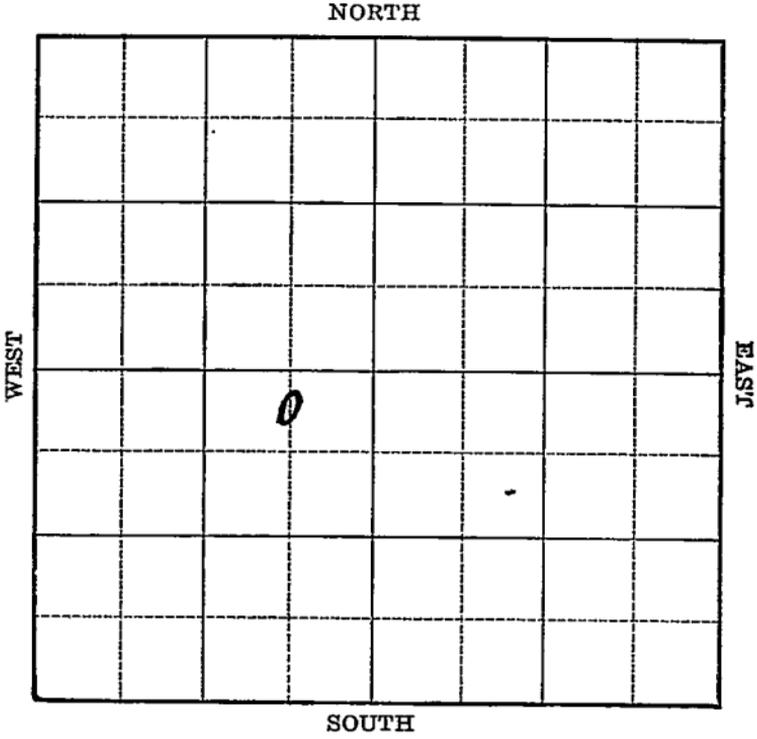

Sec. 27 Twp. 16 R. 10-W

Well No. #1 Schroeder Farm

Texas

Company

(Stoltenberg)


330 Ft. from N. Line

\_\_\_\_\_ Ft. from S. Line

660 Ft. from E. Line

\_\_\_\_\_ Ft. from W. Line

Elev. 1824

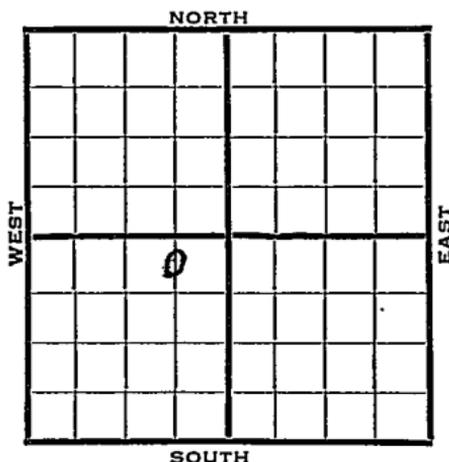

1940	REPORT
4/3	S. H.
4/12	10" - 360' Drlg. 1750'
4/18	Lans. 2948' Arb. 3275'
	T.D. 3280' Run csg.
4/25	7" - 3275' T.D. 3290'
	1000 acid. Pump 40 bbls. per
	hour. 1000 acid. No test.
5/2	Testing.
5/8	Arb. 3275'
	7" @ 3275'
	Total depth 3290'
	5000 gals acid
	Depthograph Potential 1407 oil and
	2% water.
	<b>COMPLETED</b>

Map No. 55 Sec. 27 Twp. 16 R. 10WWell No. 1 SchroederTexas

Company \_\_\_\_\_

~~FIRST REPORT~~

Contractor \_\_\_\_\_

## SECTION PLAT

C  $N\frac{1}{2}$  NE SW330 Ft. from N. Line

\_\_\_\_\_ Ft. from S. Line

660 Ft. from E. Line

\_\_\_\_\_ Ft. from W. Line

STOLTENBERG POOL

	o		

Location \_\_\_\_\_

## RECORD

Cased \_\_\_\_\_ in., \_\_\_\_\_ ft.

Sand \_\_\_\_\_

Gas \_\_\_\_\_

Oil \_\_\_\_\_

Total Depth \_\_\_\_\_

Rig up \_\_\_\_\_

Drilling and Remarks:

S.H.

## PRODUCTION

1st 24 hrs. Nat. \_\_\_\_\_

1st 24 hrs. after shot \_\_\_\_\_

Gas \_\_\_\_\_ Cu. Ft.

Dry Hole \_\_\_\_\_

Abandoned \_\_\_\_\_

Date

APR 3 1940 19

S. J. LEWIS Scout

Ellsworth

Map No. 58 Sec. 27 Twp. 16 R. 10W

Well No. 1 Schroeder

Texas

Company

Contractor

**COMPLETED**

C N  $\frac{1}{2}$  NE SW

330 Ft. from N. Line

\_\_\_\_\_ Ft. from S. Line

660 Ft. from E. Line

\_\_\_\_\_ Ft. from W. Line

**STOLTENBERG POOL**

**SECTION PLAT**

	o		

Location \_\_\_\_\_

Rig up \_\_\_\_\_

Drilling and Remarks:

*Ar 8 3275.*  
*7" @ 3275*  
*5000 acid*  
*Depthograph P.S.*  
*1407 + 2% Water*

**RECORD**

Cased \_\_\_\_\_ in., \_\_\_\_\_ ft.

Sand \_\_\_\_\_

Gas \_\_\_\_\_

Oil \_\_\_\_\_

Total Depth 3290

**PRODUCTION**

1st 24 hrs. Nat. \_\_\_\_\_

1st 24 hrs. after shot \_\_\_\_\_

Gas \_\_\_\_\_ Cu. Ft.

Dry Hole \_\_\_\_\_

Abandoned \_\_\_\_\_

Date

MAY 8 1940 19

S. J. LEWIS Scout