

KANSAS

Form 51-5M-7-40-Palace


Ellsworth

Section 27 Township 16 Range 10-W

Well No. #2 Schroeder

Company Texas

NORTH Stoltenberg Pool

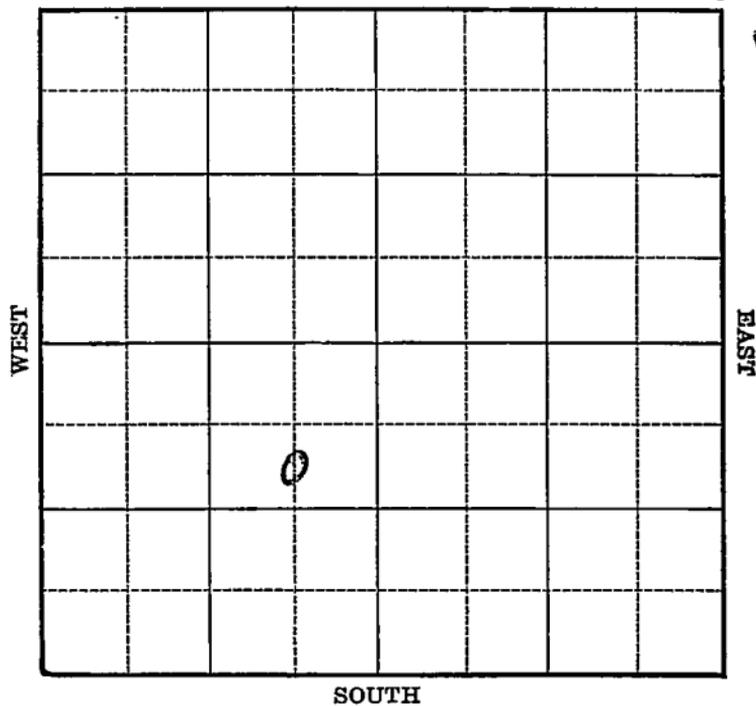

Sec. 27 Twp. 16 R. 10-W

Well No. #2 Schroeder Farm

Texas Company

(Stoltenberg)


990 Ft. from N. Line

_____ Ft. from S. Line

660 Ft. from E. Line

_____ Ft. from W. Line

Elev. 1822

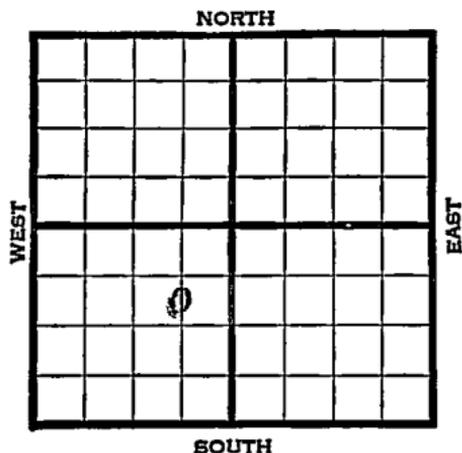

1940	REPORT
8/21	Derrick.
9/5	Drlg. 3250'
9/12	Arb. 3268' 7" - 3268'
	T.D. 3290' Jet 1000 acid.
	Swab 3 bbls. per hour.
9/18	Arb. 3268'
	7" - 3268'
	T.D. 3290'
	6000 acid.
	Depthograph potential 5083 bbls.
	Maximum 3000 bbls.
	COMPLETED

Map No. _____ Sec. 27 Twp. 16 R. 10WWell No. 2 SchroederTexas_____
Company_____
Contractor**FIRST REPORT**

C S L NE SW

990 Ft. from N. Line

____ Ft. from S. Line

660 Ft. from E. Line

____ Ft. from W. Line

STOLTENBERG POOL**SECTION PLAT**

Location _____

Rig up _____

Drilling and Remarks:
Derrick**RECORD**

Cased _____ in., _____ ft.

Sand _____

Gas _____

Oil _____

Total Depth _____

PRODUCTION

1st 24 hrs. Nat. _____

1st 24 hrs. after shot _____

Gas _____ Cu. Ft.

Dry Hole _____

Abandoned _____

Date

AUG 21 1940 19 _____S. J. LEWIS Scout

