

KANSAS


Ellsworth

Form 51-5M-7-40-Palace

Section 27 Township 16 Range 10-W

Well No. #4 Schroeder

Company Texas Co.

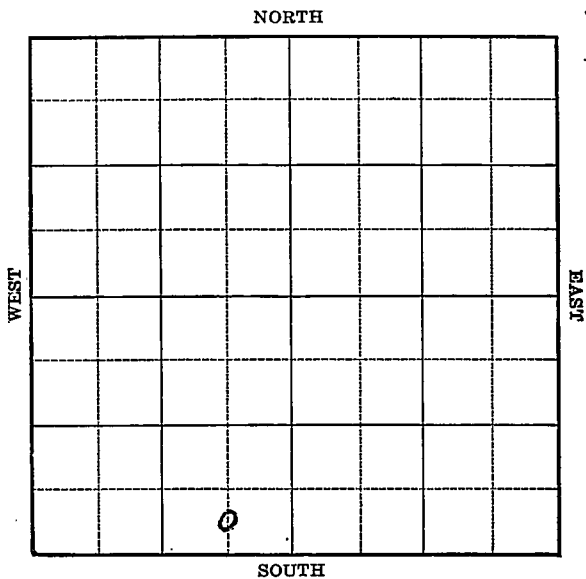


Sec. 27 Twp. 16 R. 10-WWell No. #4 Schroeder FarmTexas

Company

(Stoltenberg)

 Ft. from N. Line330 Ft. from S. Line66.0 Ft. from E. Line Ft. from W. Line

Elev. 1821

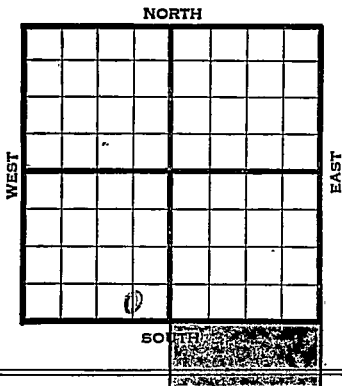

1941

16' H well #3
Level " n # ✓

REPORT

2/12

Derrick.

2/20

10" - 356' Dlg. 2660'

2/27

Arb. 3271-73 ID 7" 3271 Rust

2/26

Top Arbuckle 3271 Dlg. 3288

200' oil in 1 hr. Dlg. deeper (Texas)

2/27

T.D. 3288 Swabbing 20 barrels per hour

Will drill deeper, run tubing and
acidize (Texas)

2/27

T.D. 3288 Acidized 1000 gallons

Shut in (Texas)

Running 16' higher on Arbuckle than Atlantic
#3 Stoltenberg east offset completed for
393 bbls. on pumpRunning level on Arbuckle with our #2 Matosh
C N/2 NE NE 34-16-10 completed for depthograph
potential of 3815 bbls. (Frost)

OVER

OVER

1941

3/4--Top Arbuckle 3271 T.D. 3273

Set 7" 3271

Deepened to T.D. 3288

Total fill up 2800 feet oil

Filled up at rate of 200 feet per hour

Swabbed 20 bbls. per hour (no time given)

Acidized 1000 gallons ⁴⁰⁰ (Tel)

Depthograph potential ~~600~~ 400 bbls.

3/5

Arb. 3271'

7" - 3271'

T.D. 3288'

1000 acid.

Depthograph potential 400 bbls.

(Corrected)

44. Gravity

COMPLETED

Map No. 55 Sec. 27 Twp. 16 R. 10WWell No. 4 Schroeder

Texas

Company

FIRST REPORT

Contractor

C S L SE SW

SECTION PLAT

 Ft. from N. Line330 Ft. from S. Line660 Ft. from E. Line Ft. from W. Line

STOLTENBERG POOL

Location Rig up

Drilling and Remarks:

Derrick

RECORDCased in., ft.Sand Gas Oil Total Depth **PRODUCTION**1st 24 hrs. Nat. 1st 24 hrs. after shot Gas Cu. Ft.Dry Hole Abandoned

Date

FEB 12 1941

19

S. J. LEWIS

Scout

Map No. 55 Sec. 27 Twp. 16 R. 10W

Well No. 4 Schroeder

Texas

Company

Contractor

COMPLETED

SECTION PLAT

C S L SE SW

 Ft. from N. Line

330 Ft. from S. Line

660 Ft. from E. Line

 Ft. from W. Line

STOLTENBERG POOL

Location

Rig up

Drilling and Remarks:

Cor 83271

7" 83271

1000 acid

Dep't to 400

Corrected

440 Gr

RECORD

Cased in., ft.

Sand

Gas

Oil

Total Depth 3288

PRODUCTION

1st 24 hrs. Nat.

1st 24 hrs. after shot

Gas Cu. Ft.

Dry Hole

Abandoned

Date

MAR 5 1941

S. J. LEWIS Scout