


DX 78-1

Barton KANSAS

Section 15 Township 17 Range 14 W

Well No. # 5 Eveleigh

Company Republic Nat. Gas

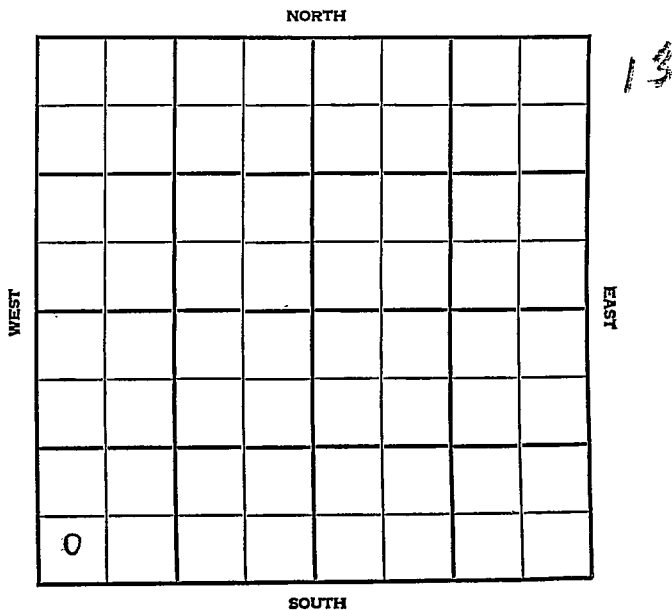

Barton KANSAS


SEC.	TWP.	R.
15	17	14W

WELL NO. 5 Eveleigh FARM

COMPANY Republic Nat. Gas

CONTRACTOR Gabbert-Jones
Boyd Pool

_____ Ft. from N. Line
330 _____ Ft. from S. Line
_____ Ft. from E. Line
330 _____ Ft. from W. Line

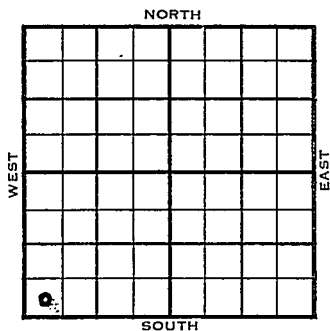

SW SW SW

1954 ELEVATION 1875' REPORT

8/11 Spud 8-9-54
11/3 Spud 8-9-54
Oil Well
TD 3375'
8-5/8" @ 837'
Heeb 3042', Br. Lime 3110' Lans 3118'
DST 3125'-53' opn 1 hr, rec 100' Muddy s.w. 0#
DST 3170'-3212' opn 1 hr, rec 195' muddy s.w. 0#
Arb 3369'
DST 3369'-72' opn 1 hr, rec 7' Mud 0#
DST 3370'-75' opn 1 hr, rec 42' so & gcm, 940#
TD 3375'
5" @ 3370'
CO to 3375'
B/ 1/2 boph 500 A S/ 7 boph 4 hr.
Comp 114 bopd.

COMPLETED

