


Ellsworth

KANSAS

Section 27 Township 16 Range 10^W

Well No. 5 Schroeder

Company Texas

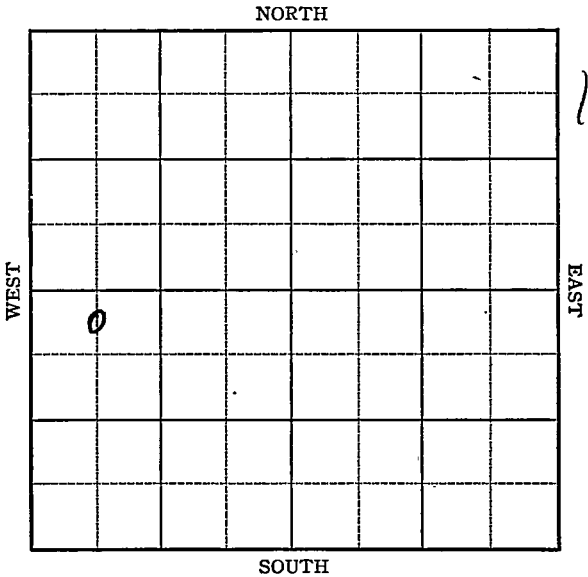

Map No. 55 Sec. 27 Twp. 16 R. 10WWell No. 5 SchroederTexas

Company

Contractor

FIRST REPORT

C N L NW SW

SECTION PLAT

D			

330 Ft. from N. Line

Ft. from S. Line

Ft. from E. Line

660 Ft. from W. Line

STOLTENBERG POOL

Location

Rig up

Drilling and Remarks:

Rotary

RECORD

Cased _____ in., _____ ft.

Sand _____

Gas _____

Oil _____

Total Depth _____

PRODUCTION

1st 24 hrs. Nat. _____

1st 24 hrs. after shot _____

Gas _____ Cu. Ft.

Dry Hole _____

Abandoned _____

Date

JUN 11 1941

S. J. LEWIS Scout

Map No. _____ Sec. 27 Twp. 16 R. 10WWell No. 5 Schroeder

_____ Texas _____ Company

_____ Contractor
COMPLETED**SECTION PLAT**

6			

C N L NW SW

330 Ft. from N. Line

_____ Ft. from S. Line

_____ Ft. from E. Line

660 Ft. from W. Line**STOLTENBERG POOL**

Location _____

Rig up _____

Drilling and Remarks:

*CR X 3288**5" @ 3288'**Pump 374 Bx.**44° Ge***RECORD**

Cased _____ in., _____ ft.

Sand _____

Gas _____

Oil _____

Total Depth 8305 1/2**PRODUCTION**

1st 24 hrs. Nat. _____

1st 24 hrs. after shot _____

Gas _____ Cu. Ft.

Dry Hole _____

Abandoned _____

Date

III 9 1941 19 S. J. LEWIS Scout