

KANSAS


FORM 51 5M 1-42 PETROL

Ellsworth

Section 26 Township 16 Range 10-W

Well No. #2 Wamhoff

Company Benson Drilling

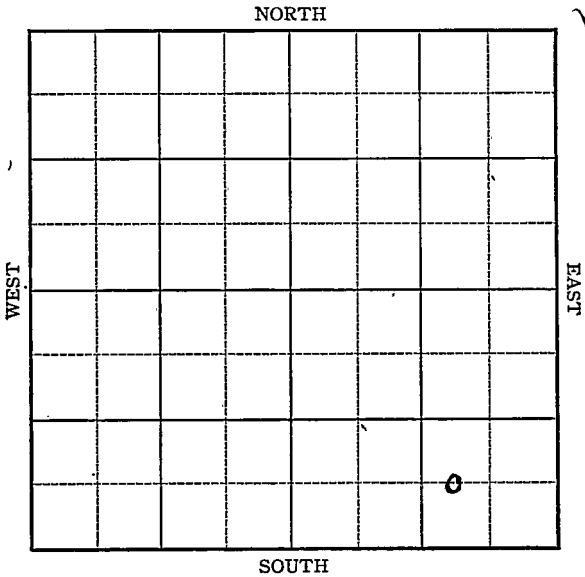

Sec. 26 Twp. 16 R. 10-W

Well No. #2 Wamhoff Farm

Benson Drilling Company


Stoltenberg

 Ft. from N. Line

660 Ft. from S. Line

990 Ft. from E. Line

 Ft. from W. Line

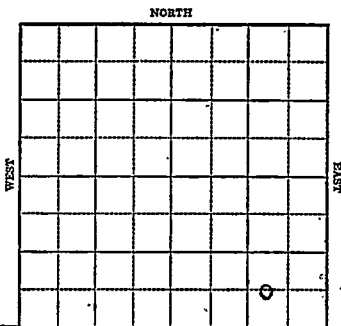

Elev. ^{SOUTH} 1849

R E P O R T

1943

- 6/9 15" @ 352
Drlg. 497'
- 6/16 Anhy 605
Drlg. 1400'
- 6/23 12" @ 490'
10" @ 1910'
Drlg. 2010'
- 6/30 Drlg. 2835'
- 7/7 Lans 2990
Arb. 3343-49 TD SO
6" @ 3343'
RUST
- 7/14 Arb. 3343
6" @ 3343'
T.D. 3353'
HFW

ABANDONED

KANSAS

Ellsworth

Map No. 55 Sec. 26 Twp. 16 R. 10WWell No. 2 WamhoffBenson Drilling Company

FIRST REPORT

Contractor

C W L S E S E

SECTION PLAT

 Ft. from N. Line660^u Ft. from S. Line990 Ft. from, E. Line Ft. from W. Line

			0

STOLTENBERG POOL

Location Rig up

Drilling and Remarks:

15"-352'

Dr1g. 497'

RECORD

Cased in., ft.Sand Gas Oil Total Depth

PRODUCTION

1st 24 hrs. Nat. 1st 24 hrs. after shot Gas Cu. Ft.Dry Hole Abandoned

Date

JUN 9 1943 19

S. J. LEWIS Scout

KANSAS

Map No. 55 Sec. 26 Twp. 16 R. 10W

Well No. 2 Wamhoff

Benson Drilling Company

ABANDONED Contractor

C WL SE SE

SECTION PLAT

_____ Ft. from N. Line

660 Ft. from S. Line

990 Ft. from E. Line

_____ Ft. from W. Line

STOLTENBERG POOL

Location _____

Rig up _____

Drilling and Remarks:

Cor 83343

6" @ 3343

HFW

RECORD

Cased _____ in., _____ ft.

Sand _____

Gas _____

Oil _____

Total Depth 6725

PRODUCTION

1st 24 hrs. Nat. _____

1st 24 hrs. after shot _____

Gas _____ Cu. Ft.

Dry Hole _____

Abandoned _____

Date

JUL 14 1943 19

S. J. LEWIS Scout