

Well No. 25 Wamhoff (KGS DRL)

Stoltenberg Pool

WEST

EAST

SOUTH

Sec. 26 Twp. 16 R. 10-W ✓

Well No. #2⁵ Wamhoff (KGS DRL) Farm

Bennett & Brunson Company

1320' Stoltenberg


660 Ft. from N. Line

_____ Ft. from S. Line

_____ Ft. from E. Line

330 Ft. from W. Line

C W L NW SE

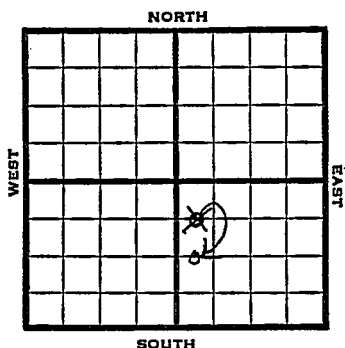

1948 Elev. 1848' REPORT

12/22	8" @ 354 Drlg 1410'
12/29	Simpson 3310 Drlg 3325'
1/5	Lansing 2992' Arbuckle 3335' TD 3336' 5" @ 3333'
1/12	"
1/19	"
1/26	"
2/2	"
2/8	"
2/16	"
2/23	"
3/2	"
3/8	"
3/16	TD 3340 1000 acid Swb 33 bbls oil / 68 W 8 hrs.
3/23	"
3/30	Arb. 3335' TD 3340' ABANDONED

Map No. _____ Sec. 26 Twp. 16 R. 10W

Well No. 25 Wamhoff (K65 DRL)

Bennett & Brunson _____ Company

FIRST REPORT

Contractor

C W L NW SE


SECTION PLAT

660 Ft. from N. Line

_____ Ft. from S. Line

_____ Ft. from E. Line

330 Ft. from W. Line

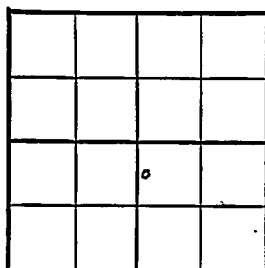

Ellsworth County

Location _____

Rig up _____

Drilling and Remarks:

8" @ 354

drlg. 1410

RECORD

Cased _____ in., _____ ft.

Sand _____

Gas _____

Oil _____

Total Depth _____

PRODUCTION

1st 24 hrs. Nat. _____

1st 24 hrs. after shot _____

Gas _____ Cu. Ft.

Dry Hole _____

Abandoned _____

Date

DEC 22 1948 19

S. J. LEWIS

Scout

Kansas

Map No. 55 Sec. 26 Twp. 16 R. 10WWell No. 2 ⁵ Wamhoff (KGS ORL)


Bennett & Brunson Company

CORRECTION

Contractor

C W L SE

SECTION PLAT

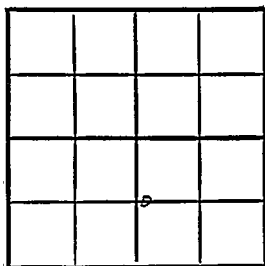1320 Ft. from N. Line Ft. from S. Line Ft. from E. Line330 Ft. from W. Line

Ellsworth County

Location Rig up Drilling and Remarks:

Reported

C W L NW SE

RECORD

Cased in., ft.Sand Gas Oil Total Depth

PRODUCTION:

1st 24 hrs. Nat. 1st 24 hrs. after shot Gas Cu. Ft.Dry Hole Abandoned

Date

JAN 5 1949

19

S. J. LEWIS

Scout


Kansas

Stoltenberg Pool

Map No. 55 Sec. 26 Twp. 16 R. 10WWell No. 2⁵ Wamhoff (KGS PRL)Bennett & Brunson Company**ABANDONED**

Contractor

C W L SE

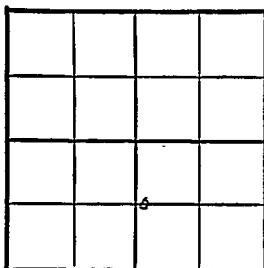E. 1845
SECTION PLAT1320 Ft. from N. Line Ft. from S. Line Ft. from E. Line330 Ft. from W. Line

Ellsworth County

Location Rig up

Drilling and Remarks:

Car 8325

RECORD

Cased in., ft.Sand Gas Oil Total Depth 340

PRODUCTION

1st 24 hrs. Nat. 1st 24 hrs. after shot Gas Cu. Ft.Dry Hole Abandoned

Date

MAR 30 1949 19

S. J. LEWIS

Scout