


KANSAS

Ellsworth county

Section 26 Township 16 Range 10-W

Well No. #4³ Wamhoff (K65 DRL)

Company Benson Drilling

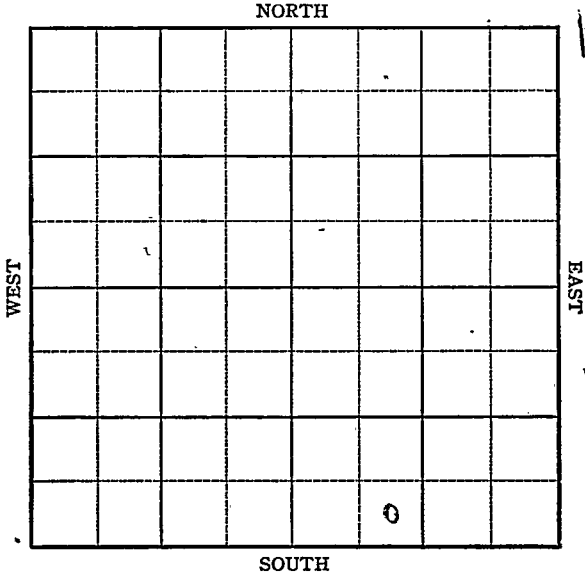

KANSAS

Ellsworth ✓

Sec. 26 Twp. 16 R. 10W

Well No. #4 Ramhoff (K65 DRL) Farm

Benson Drlg Company

Bloomer


Ft. from N. Line

330 Ft. from S. Line

Ft. from E. Line

990 Ft. from W. Line

SE SW SE

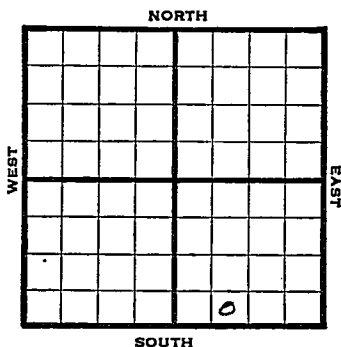

1946 Elev. 1847' REPORT

11/13 RUR
11/20 10" @ 365'
Anhy 580'
Drlg 1875'
11/27 1/2 Lans 2987'
Drlg 3223'
12/4 Arb 3353'
TD 3365'

ABANDONED

Map No. 55 Sec. 26 Twp. 16 R. 10W

Well No. A Wamhoff (KGS DKL)

Benson Drig.

Company

FIRST REPORT

Contractor

SE SW SE

SECTION PLAT

Ft. from N. Line

330 Ft. from S. Line

Ft. from E. Line

990 Ft. from W. Line

Ellsworth County

Location

Rig up

Drilling and Remarks:

R U R

RECORD

Cased _____ in., _____ ft.

Sand _____

Gas _____

Oil _____

Total Depth _____

PRODUCTION

1st 24 hrs. Nat. _____

1st 24 hrs. after shot _____

Gas _____ Cu. Ft.

Dry Hole _____

Abandoned _____

Date

NOV 13 1946

S. J. LEWIS

Scout

KANSAS Bloomer Pool
KansasMap No. 15 Sec. 26 Twp. 16 R. 10WWell No. A³ Wamhoff (KGS DRL)


Benson Drlg.

Company

ABANDONED.

Contractor

SE SW SE

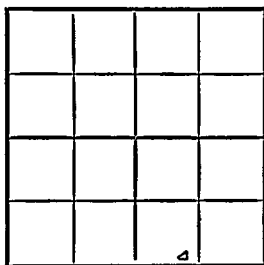E11847
SECTION PLAT Ft. from N. Line330 Ft. from S. Line Ft. from E. Line990 Ft. from W. Line

Ellsworth County

Location Rig up

Drilling and Remarks:

See 10853

RECORD

Cased in, ft.Sand Gas Oil Total Depth 226.5

PRODUCTION

1st 24 hrs. Nat. 1st 24 hrs. after shot Gas Cu. Ft.Dry Hole Abandoned

Date

DEC 4 1946 19

S. J. LEWIS

Scout