KANSAS Ellsworth


Form 51—5M—7-40—Palace

Section 27 Township 16 Range 10-W

Well No. #3 Schroeder

Company Texas

14

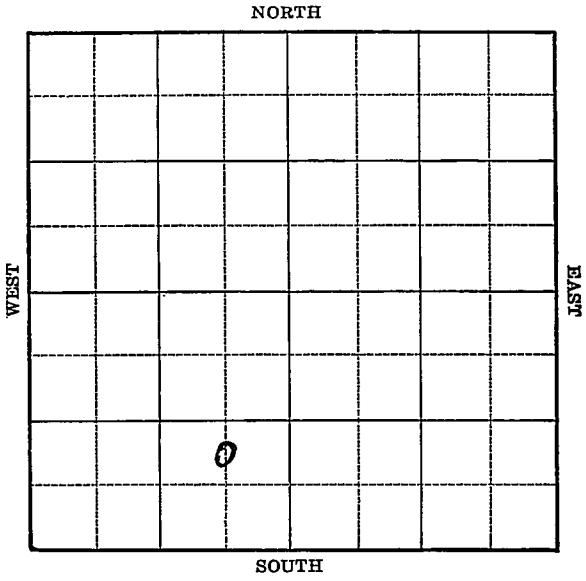

FORM 252-A 5M 7-40 PETROL KANSAS Ellsworth

Sec. 27 Twp. 16 R. 10-W

Well No. #3 Schroeder Farm

Texas Company


(Stoltenberg)

_____ Ft. from N. Line

990 Ft. from S. Line

660 Ft. from E. Line

_____ Ft. from W. Line

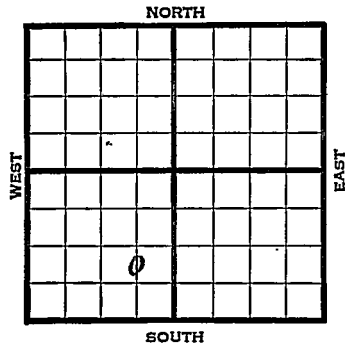

Elev. 1820

1940	REPORT
12/30	Location
1941	
1/9	10" - 370' Drlg. 1700'
1/16	Arb. 3269-70' T.D. 7" - 3269'
	RUST.
1/23	"
1/29	Arb. 3269'
	7" - 3269'
	T.D. 3276'
	Depthograph potential 3549 bbls.
	Maximum 3000 bbls.
	44. Gravity
	COMPLETED

Form 26—200 Bks.—1-40—Palace Ellsworth KANSAS

Map No. 55 Sec. 27 Twp. 16 R. 10W

Well No. 3 Schroeder

Texas Company

FIRST REPORT Contractor

C N L SE SW

_____ Ft. from N. Line


990 Ft. from S. Line

660 Ft. from E. Line

_____ Ft. from W. Line

STOLTENBERG POOL

SECTION PLAT

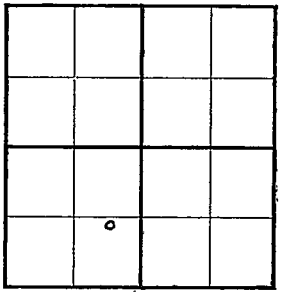

Location X

Rig up

Drilling and Remarks:

RECORD

Cased _____ in., _____ ft.

Sand

Gas

Oil

Total Depth

PRODUCTION

1st 24 hrs. Nat.

1st 24 hrs. after shot

Gas _____ Cu. Ft.

Dry Hole

Abandoned

Date

DEC 30 1940 19 S. J. LEWIS Scout

Form 26—200 Bks.—1-40—Palace Ellsworth KANSAS

Map No. 55 Sec. 27 Twp. 16 R. 10W

Well No. 3 Schroeder

Texas Company

COMPLETED Contractor

C N L SE SW

____ Ft. from N. Line


990 Ft. from S. Line

660 Ft. from E. Line

____ Ft. from W. Line

STOLTENBERG POOL

SECTION PLAT

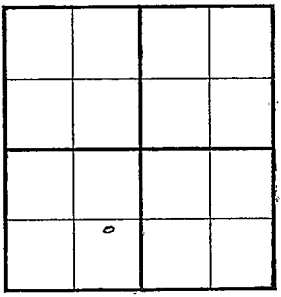

Location ____

Rig up ____

Drilling and Remarks:

Cu @ 3269

7" @ 3269

Depth. Pb @ 3549

Mud @ 3000

44° Gr.

RECORD

Cased ____ in., ____ ft.

Sand ____

Gas ____

Oil ____

Total Depth 3276

PRODUCTION

1st 24 hrs.-Nat. ____

1st 24 hrs. after shot ____

Gas ____ Cu. Ft.

Dry Hole ____

Abandoned ____

Date

JAN 29 1941 19 S. J. LEWIS Scout