

KANSAS


Ellsworth

FORM 51 5M 10-41 PETROL

Section 27 Township 16 Range 10-W

Well No. #6 Schroeder

Company Texas

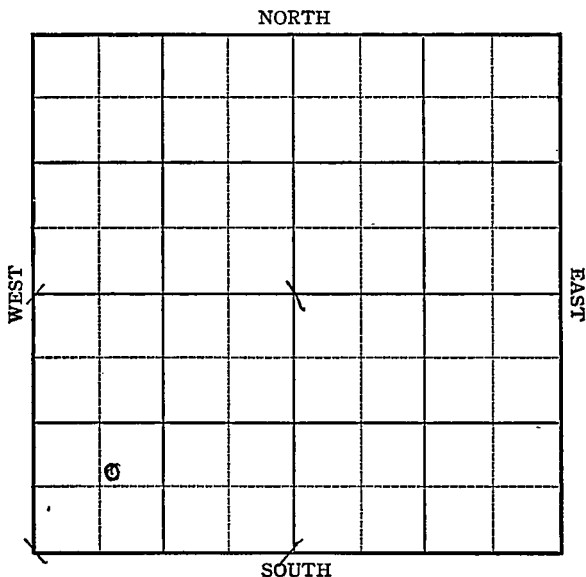

KANSAS

Ellsworth

Sec. 27 Twp. 16 R. 10-W

Well No. #6 Schroeder Farm

Texas

Company

Stoltenberg


Ft. from N. Line

766 Ft. from S. Line

Ft. from E. Line

766 Ft. from W. Line

Elev. 1832

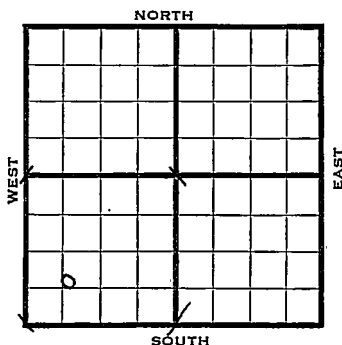

1943

REPORT

1/6	Location
1/13	"
1/20	Rotary.
1/27	"
2/3	10" casing set 353' Drlg. 1905'
2/10	Drlg. 2775'
2/17	Arb 3276-79 TD 5" Casing set 3277 RUST
2/24	TD 3289 Swab 8 bbls oil per 8 hrs
3/3	Arb. 3276 T.D. 3289' 5" @ 3277' Pump 475 Pot. Gravity 43.2

COMPLETED

Ellsworth


KANSASMap No. 53 Sec. 27 Twp. 16 R. 10WWell No. 6 SchroederTexas

Company

FIRST REPORT

Contractor

C SW SW

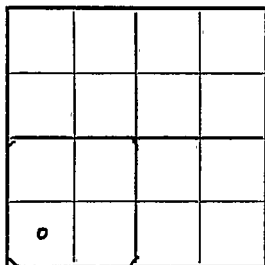SECTION PLAT Ft. from N. Line766 Ft. from S. Line Ft. from E. Line766 Ft. from W. Line**STOLTENBERG POOL**Location XXXRig up

Drilling and Remarks:

RECORDCased in., ft.Sand Gas Oil Total Depth **PRODUCTION**1st 24 hrs. Nat. 1st 24 hrs. after shot Gas Cu. Ft.Dry Hole Abandoned

Date

JAN 6 1943 19S. J. LEWIS Scout

Map No. KANSAS Sec. 27 Twp. 16 R. 10W

Well No. 6 Schroeder

Texas Company

COMPLETED Contractor

C SW SW

 Ft. from N. Line

766 Ft. from S. Line

 Ft. from E. Line

766 Ft. from W. Line

SECTION PLAT

0			

STOLTENBERG POOL

Location

Rig up

Drilling and Remarks:

Cer 88276

5' 03277

Pump 175 BX

43 1/2 Gr

RECORD

Cased in., ft.

Sand

Gas

Oil

Total Depth 0289

PRODUCTION

1st 24 hrs. Nat.

1st 24 hrs. after shot

Gas Cu. Ft.

Dry Hole

Abandoned

Date

MAR 3 1943 19

S. J. LEWIS Scout