


Ellsworth

Form 51-5M-2-29-34703

Map No. **KANSAS** Sec. 27 Twp. 16 R. 10^W

Well No. 17 Choltenburg Farm
Vickers Per et al Company

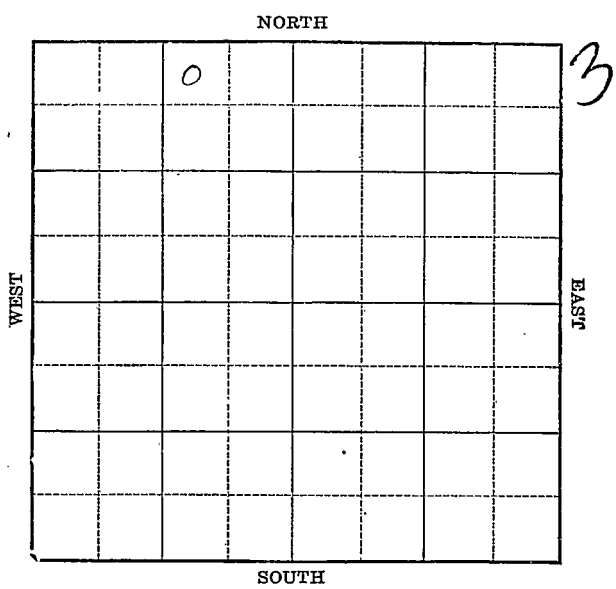

Location _____
Drilling Remarks _____

Rig Up _____
Drilling Remarks _____

RECORD

Cased _____ in. _____ ft.
Sand _____
Gas _____
Oil _____
Total Depth _____

PRODUCTION

1st 24 hrs. Nat. _____
1st 24 hrs. after shot _____
Gas _____ cu. ft. _____
Dry Hole _____
Abandoned _____

Map No. **KANSAS** Sec. 27 Twp. 16 R. 10^W
Well No. 1-Holtenburg Farm
Vickers Pet et al Company


330. Ft. from N. Line

 Ft. from S. Line

940 Ft. from E. Line

 Ft. from W. Line

1932

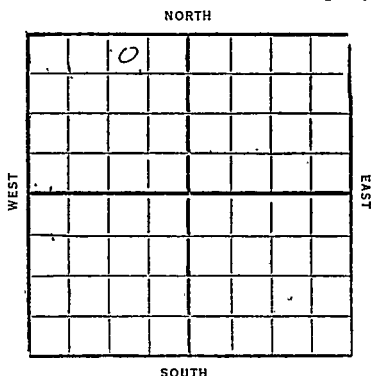

Date

REPORT

1/20

BoS

1/27

Bldg rig

2/3

Run up

2/10

F

2/17

F

2/26

Spdg.

3/2

15"-430

Drilg 840'

3/9

12 1/2"-1000

SD 1425'

3/16

Drilg 1850'

3/22

U/P 10"-2200'

3/30

Drilg 2605'

4/6

8"-3103

TD 3107 Cld out

4/9

Top Silic lens 3308

TD 3317

Small show oil

Rng 6 5/8" casing

(over)

4/11- Top Silic. lime 3308
Show oil 3317 6"-3309
" " 3325
Encountered pay 3331
T.D. 3335
filled 2300' oil 3 hours
Culling big pipe
May deepen

4/13- T.D. 3335'
Hole full oil in 16 hrs

4/20- T.D. 3335
swab 42 bbls per hr.
for first 3 hrs
Prep. to pump.

4/27- Cased 6"-3309
Siliceous 3308-35
Pay 3331-34
T.D. 3335
800 bbls oil
Potential prod
Comp.

Ellsworth

KANSAS
Map No. 535 Sec. 77 Twp. 16 R. 10 W

Well No. 1 Stoltenberg

Vickers Pnt & Co Company

Contractor

FIRST REPORTS

330 Ft. from N. Line

Ft. from S. Line

990 Ft. from E. Line

Ft. from W. Line

SECTION PLAT

	0		

Location

Rig up

Drilling and Remarks:

RECORD

Cased in, ft.

Sand

Gas

Oil

Total Depth

PRODUCTION

1st 24 hrs. Nat.

1st 24 hrs. after shot

Gas Cu. Ft.

Dry Hole

Abandoned

Date

JAN 20 1932

192 CHAS. L. SHERWOOD Scout

Ellsworth

55 KANSAS

Map No. _____ Sec. 27 Twp. 16 R. 10 W

Well No. 1 Staltemberg

Vickers Oil & Gas Company

Contractor

COMPLETE

330 Ft. from N. Line

Ft. from S. Line

990 Ft. from E. Line

Ft. from W. Line

SECTION PLAT

Location _____

Rig up _____

Drilling and Remarks:

Pay 3331-34

Potential Prod

800 Bl.

RECORD

Cased 6 in., 3309 ft.

Sand 3308-35

Gas _____

Oil _____

Total Depth 3335

PRODUCTION

1st 24 hrs. Nat. _____

1st 24 hrs. after shot _____

Gas _____ Cu. Ft.

Dry Hole _____

Abandoned _____

Date

APR 27 1932

CHAS. L. SHERWOOD

Scout