

Section 16 Township 17 Range 11WWell No. 1 ConnerCompany H. G. Kaiser et al

NORTH

WEST

EAST

SOUTH

14

Barton KANSAS

SEC.	TWP.	R.
16	17	14W ✓

WELL NO.

1 Conner

FARM

COMPANY

H. G. Kaiser et al

CONTRACTOR

Anschutz


Wildcat

_____ Ft. from N. Line

990 _____ Ft. from S. Line

330 _____ Ft. from E. Line

_____ Ft. from W. Line

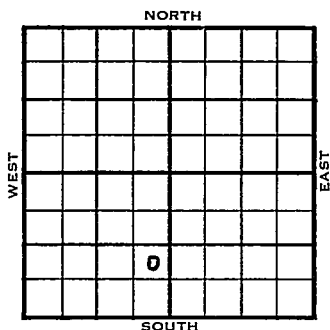

NE SE SW

	ELEVATION	REPORT
1953	1921'	

12/9 MIR

12/16 8" @ 895' Anhy 891'

12/22 Drlg. 2675'

Spud 12-8-53

D&A

TD 3474'

8" @ 895'

Anhy 891', Heeb 3085', Tor 3100', Br

Lime 3151', Lans 3162'

DST 3154-85', opn 1 hr., rec. 30' mud,

175#

B KC 3367', Cong 3376'

DST 3365-3430', opn 1 hr., rec. 15'

mud, 60#

ReArb. 3436

DST 3438-43', opn 1 hr., rec. 6' mud,

1100#

Arb. 3447'

TD 3474'

D&A

ABANDONED

County Barton State Kansas
 Sec. 16 (Blk. 17 (Sur. 14W Map No.
 (Twp.) (Rge.)
 Operator H. G. Kaiser et al.
 Well No. 1 Farm Conner

Elev. Location NE SE SW
990 Ft. From S Line SW
330 Ft. From E Line Quarter

FIRST REPORT

1st. Report DEC 9 1953

Completion

Remarks

Anschutz - Contr.

Spudding Date


Wildcat

Drlg. Data

M I R

J. G. McGEHEE

County Barton State Kansas
 Sec. 16 (Blk. 17 (Sur. 14W Map No.
 (Twp.) (Rge.)
 Operator H. G. Kaiser et al.
 Well No. 1 Farm Conner
 Elev. 1921 Location NE SE SW

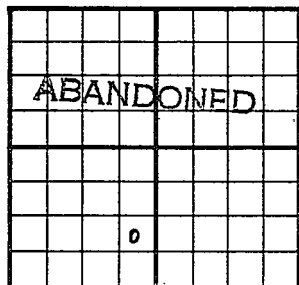

990 Ft. From S Line SW
330 Ft. From E Line Quarter

1st. Report

Completion DEC 22 1953

Remarks Wildcat

Anschutz - Contr.

Spudding Date 12-8-53

Drilg. Data D & A TD 3474

8" @ 895 Anhy 891 Heeb. 3085

Tor. 3100 Br. lime 3151 Lans. 3162

DST 3154-85 open 1 hr. Rec. 30' mud

175# B KC 3367 Cong. 3376 DST 3365-3430

open 1 hr. Rec. 15' mud 60# ReArb. 3436

DST 3438-43 open 1 hr. Rec. 6' mud

1100# Arb. 3447 TD 3474

D & A

J. G. McGEHEE