

KANSAS

Form 51-5M-7-39-Palace


Ellsworth

Section 27 Township 16 Range 10-W

Well No. #1 Stoltenberg "A"

Company Atlantic Refining

NORTH **Stoltenberg Pool**

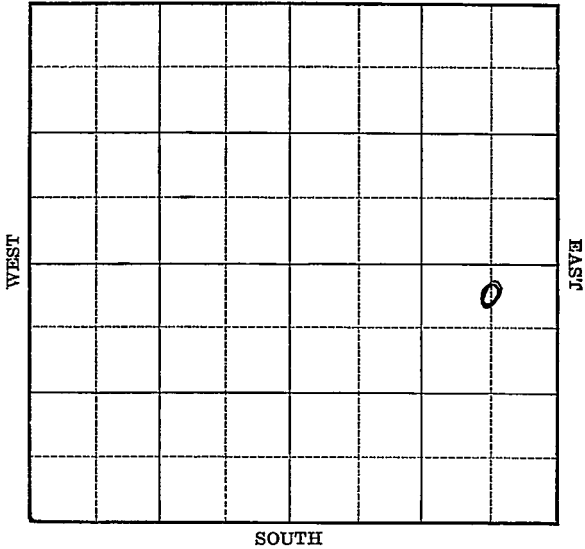

Sec. 27 Twp. 16 R. 10-W

Well No. #1 Stoltenberg "E" Farm

Atlantic Refg. Company

(Stoltenberg)


330 Ft. from N. Line

_____ Ft. from S. Line

660 Ft. from E. Line

_____ Ft. from W. Line

Elev. 1840

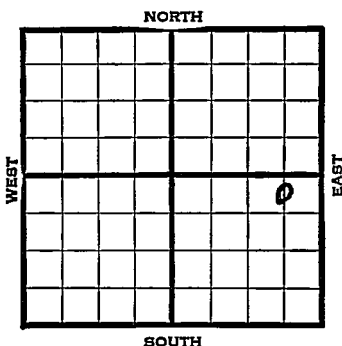

1940	REPORT
5/8	Derrick.
5/16	12" - 355' Drlg. 1750'
5/23	Fsg. 2875'
5/29	Lans. 2988' Drlg. 3240'
6/6	Arb. 3294' 7" - 3294'
	T.D. 3298' Swab 15 bbls. per hour. 1500 acid. C.O.
6/10	Potential 8227 bbls. Think Echometer
	potential Maximum 3000 bbls. (Tel)
6/12	Arb. 3294'
	7" - 3294'
	T.D. 3298'
	1500 acid.
	Depthograph potential 8227 bbls.
	Maximum 3000 bbls.
	COMPLETED

Map No. 55 Sec. 27 Twp. 16 R. 10WWell No. 1 Stoltenberg "E"Atlantic Refining Company

Contractor

FIRST REPORT**SECTION PLAT**

C N L N E S E

330 Ft. from N. Line

_____ Ft. from S. Line

660 Ft. from E. Line

_____ Ft. from W. Line

STOLTENBERG POOL

Location _____

Rig up _____

Drilling and Remarks:

Derrick**RECORD**

Cased _____ in., _____ ft.

Sand _____

Gas _____

Oil _____

Total Depth _____

PRODUCTION

1st 24 hrs. Nat. _____

1st 24 hrs. after shot _____

Gas _____ Cu. Ft.

Dry Hole _____

Abandoned _____

Date

MAY 8 1940 19S. J. LEWIS Scout

Map No. 55 Sec. 27 Twp. 16 R. 10WWell No. 1 Stoltenberg "A"Atlantic Refining Company

Contractor

COMPLETED

C N L N E S E

330 Ft. from N. Line

_____ Ft. from S. Line

660 Ft. from E. Line

_____ Ft. from W. Line

STOLTENBERG POOL

SECTION PLAT

			o

Location _____

Rig up _____

Drilling and Remarks:

*CR & 3294**7" C 3284**1500 acid**Dept. Topograph Plat.**8227**W. of 3000***RECORD**

Cased _____ in., _____ ft.

Sand _____

Gas _____

Oil _____

Total Depth 3298**PRODUCTION**

1st 24 hrs. Nat. _____

1st 24 hrs. after shot _____

Gas _____ Cu. Ft.

Dry Hole _____

Abandoned _____

Date

JUN 12 1940 19

S. J. LEWIS Scout