


Section 23 Township 32 Range 5 E

Well No. #1 Bartlow

Company Kriswell Drlg. & Glickman Oil

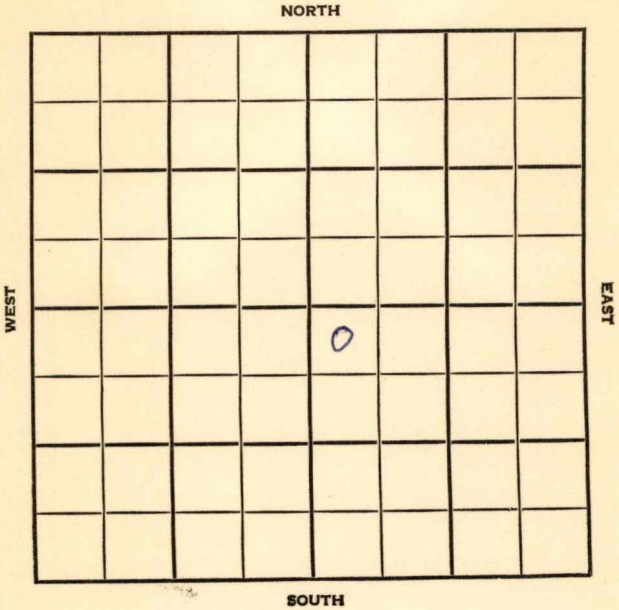

Cowley

KANSAS

SEC.

23

TWP.

32

R.

5E

WELL NO.

#1 Bartlow

FARM

COMPANY

Kriswell Drlg. & Glickman Oil


CONTRACTOR

Ft. from N. Line

Ft. from S. Line

Ft. from E. Line

Ft. from W. Line

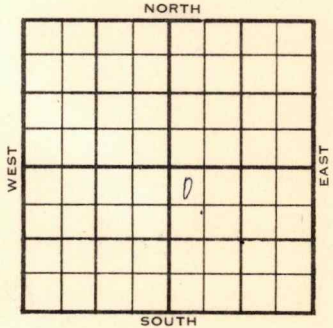

NW NW SE

1956

ELEVATION

1317

REPORT

2-8

Comm. 2-3-56

8" @ 85/75

Drlg. 460

County Cowley Elev. 1317
Sec. 23 Twp. 32 Rge. 5E
Company Kriswell Drlg. & Glickman Oil
Farm Name Bartlow No. 1

TOPS	DEPTH	LOG	DATUM
Anh.			
Tp.			
H.			
Tr.			
Dg.			
B.L.			
L.			
K.C.			
B.K.C.			
Ce.			
C.			
M.			
M.			
K.			
Mz.			
Me.			
V.			
S.			
S.			
A.			
R.			
Pf.			
G.			
T.D.			

Loc. in Sec. NW NW SE
Geol. _____
Contr. _____
Pool _____

FIRST REPORT	
0	
FEB 8 '56	

Date Comm. 2-3-56
8" @ 85/75 drlg. 460

County Cowley Elev. 1317
 Sec. 23 Twp. 32 Rge. 5E
 Company Kriswell Drlg. & Glickman Oil
 Farm Name Bartlow No. 1

TOPS	DEPTH	LOG	DATUM	Loc. in Sec.
Anb.				NW NW SE
TP.				
H. <u>Stall</u>	<u>1922</u>		<u>661</u>	
Tr. <u>bay</u>	<u>2336</u>		<u>1217</u>	
Dg.				
Bl.				
L.				
K.C.	<u>2525</u>		<u>1208</u>	Geol.
<u>OSW</u>	<u>2721</u>		<u>1404</u>	Contc.
Ce.				
C.				
M. <u>chert</u>	<u>3096</u>		<u>1759</u>	
M. <u>LI</u>	<u>3125</u>		<u>1808</u>	Pool
K.				
Mz.				
Ma.				
V.				
S.				
S.				
A.				
R.				
Pe.				
G.				
TD.	<u>3156</u>			

ABANDONED

Date Comm. 2-3-56 FEB 15 1956

8" @ 85/75 drlg. 460 FEB 15 56 DST

3106-30 up 95" 300 gals per

25' V30CM BHP 130/20

720 409

1290