


Cowley

KANSAS

Section 24 Township 32 Range 5 E

Well No. #1 Bayne

Company Beaumont Pet.

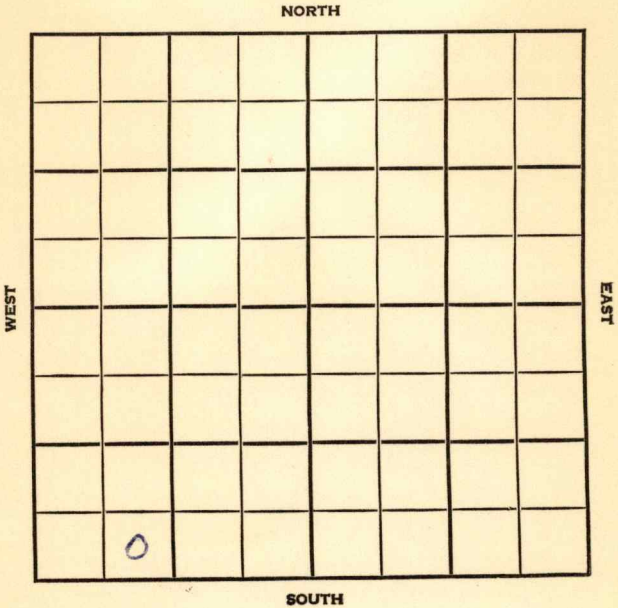

Cowley

KANSAS

|      |      |       |
|------|------|-------|
| SEC. | TWP. | R.    |
| 24   | 32   | ## SE |

WELL NO.

#1 Bayne

FARM

COMPANY

Beaumont Petr.

CONTRACTOR

Co. Tools


Winfield

Ft. from N. Line

Ft. from S. Line

Ft. from E. Line

Ft. from W. Line

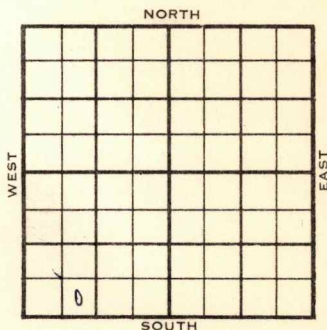

SE SW SW

ELEVATION

REPORT

1956

2-15 Comm. 2-11-56  
8" @ 134/100  
Drlg. 400

County Cowley Elev. 1298.5 KB  
 Sec. 24 Twp. 32 Rge. SE  
 Company Resumont No. 1  
 Farm Name Bayne No. 1

| TOPS              | DEPTH            | LOG | DATUM       | Loc. in Sec. |
|-------------------|------------------|-----|-------------|--------------|
| Arb.              |                  |     |             | SE SW SW     |
| TP                |                  |     |             |              |
| H. <u>124</u>     | <u>2302-2432</u> |     | <u>1004</u> |              |
| Tr.               |                  |     |             |              |
| Dr.               |                  |     |             |              |
| Bl.               |                  |     |             |              |
| L.                |                  |     |             |              |
| Rk.               | <u>2484</u>      |     | <u>1186</u> | Geol.        |
| ARC.              | <u>2604</u>      |     | <u>1306</u> | Conts.       |
| Gr. <u>Marm L</u> | <u>2703</u>      |     | <u>1405</u> | Co. tools    |
| R. <u>cash</u>    | <u>2822</u>      |     | <u>1522</u> |              |
| M. <u>chert</u>   | <u>3031</u>      |     | <u>1783</u> |              |
| M. <u>LI</u>      | <u>3098</u>      |     | <u>1800</u> | Phol.        |
| R. <u>cowley</u>  | <u>3116</u>      |     | <u>1818</u> | Winfield     |
| Mo.               |                  |     |             |              |
| Mo.               |                  |     |             |              |
| V.                |                  |     |             |              |
| E.                |                  |     |             |              |
| R.                |                  |     |             |              |
| A.                |                  |     |             |              |
| R.                |                  |     |             |              |
| Pr.               |                  |     |             |              |
| C.                |                  |     |             |              |
| RA                | <u>3125</u>      |     |             |              |

ABANDONED

Date Comm. 2-11-56

FEB 22 1956

84 @ 13/100 drlg. 400 FEB 22 56

MADE 1 AM

R. Q. R.

H. S. A.

County

Cowley

Elev.

Sec.

24

Twp.

32

Rge.

5E

Company

Beaumont Pet.

Farm Name

Bayne

No.

1

TOPS

DEPTH

LOG

DATUM

Loc. in Sec.

Anh.

SE SW SW

T.P.

H.

Tr.

Dg.

B.L.

L.

K.C.

Geol.

B.K.C.

Contr.

Ce.

Co. tools

C.

M.

Pool

M.

K.

Winfield

Mz.

Mq.

V.

S.

S.

A.

R.

Pe.

G.

FIRST REPORT

FEB 15 56

I.D.

0

Date Comm.

2 -11-56

8" @ 134/100

drlg. 400