

Cowley

KANSAS

SECTION 25 TOWNSHIP 32 RANGE 5E

WELL NO. #1 Gould

COMPANY Capitt Drlg. & Sunray Mid-Continent

NORTH

0							

WEST

EAST

SOUTH

HOT FILE Cowley KANSAS

SEC. TWP. R.
25 32 S 5 E

WELL NO.

1 Gould


FARM

COMPANY **Capitt Drlg. & SDX**
~~Mr. Paul Martin~~ (EXPLORATORY-OBOC)

CONTRACTOR

Capitt Drlg. Co. tools
Wildcat

_____ FT. FROM N. LINE
 _____ FT. FROM S. LINE
 _____ FT. FROM E. LINE
 _____ FT. FROM W. LINE

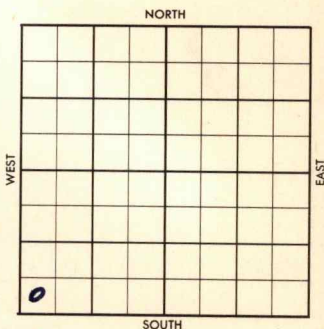

SW SW SW

SDX Lease Purchase Agreement

	ELEVATION	REPORT
1956		(WH6-BH17)
9/27	Mississippi Test appx 3150' To commence by November 1, 1956 To complete by December 1, 1956 (See copy of Lease Purch. Agrt 9/27/56)	
9/18	Spud 9-11-56 8-5/8" @ 100 w/178 TD 100' WOC	(FR Tkt) (DR#182)
9/19	TD 100' No report	
9/20	" "	
9/21	Drlg. 480'	
9/24	Drlg. 1115'	
9/25	Drlg. 2495'	
9/26	Drlg. 2750'	
9/27	Drlg. 3040'	
9/28	Drlg. 3120'	
10/1	TD 3185'. Rng. EL	
10/2	TD 3185'. Plugged & Abandoned (DR#192)	
10/8	(Advised Contract Section - P & A)	

No

Coxley

Elev. 1293

25

Tap 32

Rge. 5E

Company Capitt Drlg. & Sunray Mid-Cont.

Farm Name Gould No. 1

TOPS	DEPTH	LOG	DATUM	Loc. in Sec.
Anh.				SW SW SW
TP.	1192			
H. Stall L	1882	1881		
Tp. Stall sd		1937		
Dg.				
Bl. Laysd		2341		
L.	2098	2099		Geol.
K.C.	2498	2510		
Bkt. OSW.	2707	2709		Contr.
Ce. Barth. zn	3000			Capitt Drlg.
C.				Tools
M. chert	3085	3085		Pool
M. li	3101	3104		
K.				Wildcat
Mz.				
Me.				
V.				
S.				
S.				
A.				
R.				
PE.				
G.				
TD.	3185			

ABANDONED
OCT 3 '56

Date Comm. 9-13-56

8" @ 100 w/178, WORT 'SEP 26 '56 X 9/20/56

TP 1192 Stall. 1882 L59 2098

KC 2498 OSW 2709 2750

OCT 3 '56 X Barth. zn 3000 Miss chert

3085 DST 3085-95 up 90" rec 8'

HOCM (show free oil) BHP 90/30"

M. li 3101 RTD 3185 run

Log

D&A

County Cowley Elev. _____
 Sec. 25 Twp. 32 Rge. 5E
 Company Capitt Drlg. & Sunray Mid-Cont.
 FarmName Could No. 1

TOPS	DEPTH	LOG	DATUM	Loc. in Sec.
Anh.				SW SW SW
Tp.				
H.				
Tr.				
Dg.				
Bl.				
L.				Geol. _____
K.C.				Contr _____
B.K.C.				Capitt Drlg.
Ce.				Tools
C.				Pool
M.				Wildcat
M.				SEP 19 '56
K.				FIRST REPORT
Mz.				
Mq.				
V.				
S.				
S.				
A.				
R.				
PE.				
G.				
TR.				

Date Comm. 9-13-56
8" @ 100 w/178, WORT SEP 26 '56

(Large handwritten signature)
 SEP 5 1956
 M.M.