


Cowley

KANSAS

SECTION 25 TOWNSHIP 32S RANGE 5E

WELL NO. #1 Kindt

COMPANY McKnab-Lindsay

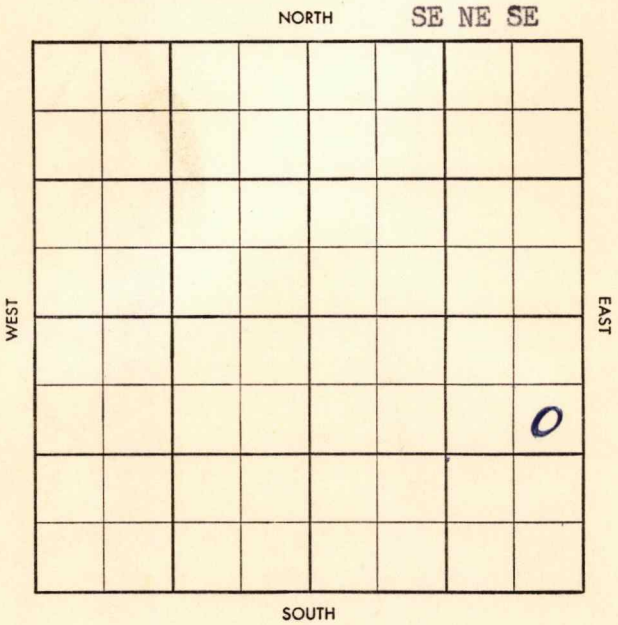

Co.

TOPS	DEPTH	LOG	DATUM
Anh.			
TP.			
H.			
Tr.			
Dg.			
B.L.			
L.			
K.C.			
B.K.C.			
Ce.			
C.			
M.			
M.			
K.			
Mz.			
Mq.			
V.			
S.			
S.			
A.			
R.			
Pf.			
G.			
T.D.			

Loc. in Sec. _____

SE NE SE

Geol.

Contr.

Pool

Turner W.

FIRST REPORT
FEB 26 1968

Date Comm.

Location

Use:

No.

Sec.

1.

不

~~Twp.~~ ~~Pool~~
~~Co.~~ ~~Facet~~

County Cowley Elev. _____
 Sec. 25 Twp. 32 Rge. 5E
 Company McKnab-Lindsay
 Farm Name Kindt No. 1

TOPS	DEPTH	LOG	DATUM
Anh.			
Tr.			
Dg.			
B.L.			
L.			
K.C.	2452		
B.K.C.			
Ce.			
C.			
M.	3072		
M.			
K.			
Mz.			
Mq.			
V.			
S.			
S.			
A.	3547		
R.			
Pf.			
G.			
T.D.	3574		

Loc. in Sec. SE NE SE

Geol. _____
 Contr. _____
 Pool Turner W.

ABANDONED

APR 23 '58

Date Comm. 2-15-58

Location MAR 5 '58 8" 120/76 woc MAR 12 '58

MAR 19 '58 MAR 26 '58 APR 2 '58 APR 9 '58 APR 16 '58

and 308-21 1/2 full rec and
3124-42 full rec and 3076
-96 full rec so 3080-84 DST 3123
45 00 1/2 5' M BHP 85/30" DST
3123-45 (AT) 2 hrs SB rec
45' MAW NO BHP no log

D.O.A