


Section 16 Township 17 Range 14W

Well No. #2 Dryden

Company Rocket Drlg.

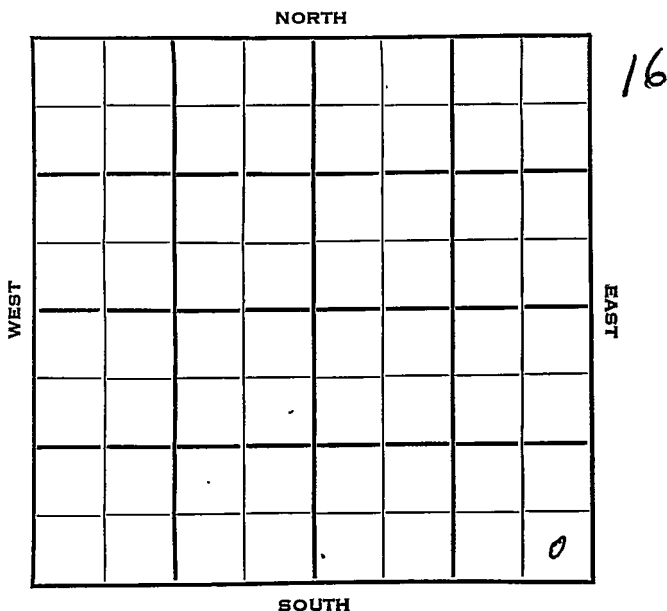

Barton

KANSAS

SEC.	TWP.	R.
16	17	11W ✓

WELL NO.

#2 Dryden FARM

Rocket Drlg.

Rocket Drlg.

Carrol Pool


NORTH

Ft. from N. Line

330 Ft. from S. Line

330 Ft. from E. Line

Ft. from W. Line

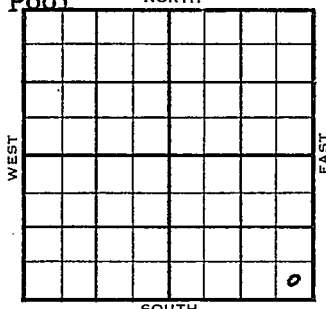

SE SE SE

	ELEVATION	REPORT
1954	1877'	

3/31 Spud 3-25-54
8" @ 606'
Heeb 3039', Br. Lime 3105', KC 3115'
Drlg 3144'

4/7 Rew Arb. 3363'
RTD 3364'
5" @ 3363'
DD 3369' TD
Arb. 3367',
Frac.

5/5 Spud 3-25-54
Oil Well
TD 3372'
8" @ 606'
Heeb 3039', Brlime 3105', KC 3115'
ReArb 3363'
TD 3364'
5" @ 3363'
DD 3369' Arb 3367' Frac. 500 A
CO DD 3372' 500 A 2 boph
Comp 60 bopd.

COMPLETED

J. G. McGEHEE

J. G. McGFHFF