

KANSAS


Butler

FORM 51 IOM 12-46 PETROL

Section 22 Township 25 Range 4E

Well No. 4 Eaton "A"

Company E. Adair et al

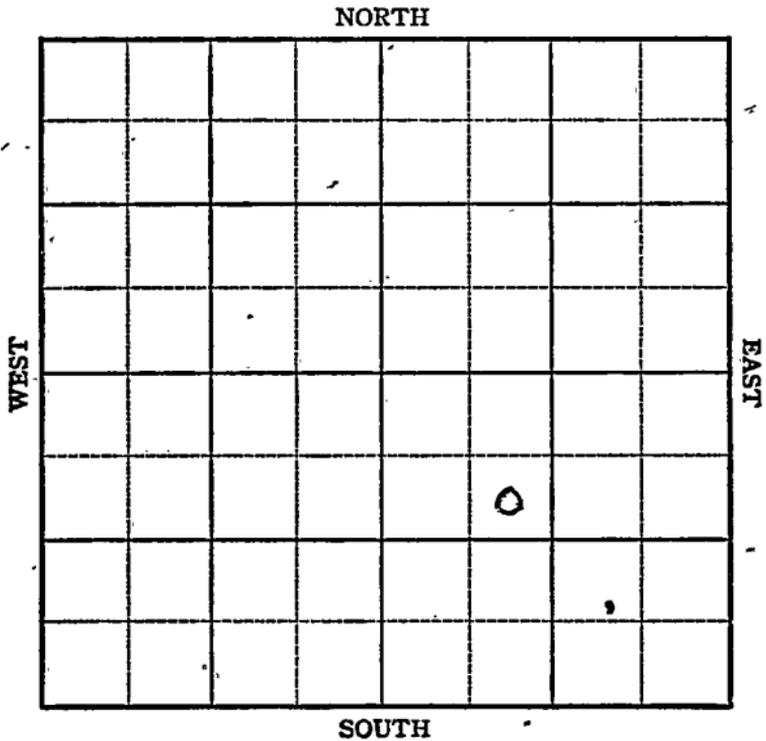




Sec. 22 Twp. _____ R. 4E

Well No. 4 Eaton "A" Farm _____
E. Adair et al Company _____

Miscellaneous
990
_____ Ft. from N. Line
_____ Ft. from S. Line
_____ Ft. from E. Line
990
_____ Ft. from W. Line

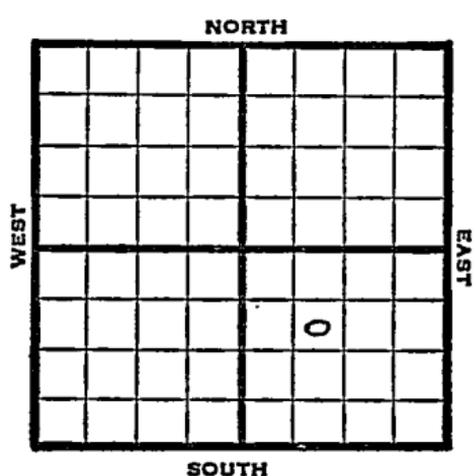

SE NW SE

1947 Elev. 1378' REPORT

- 5/28 Location
- 6/3 Mach.
- 6/10 15" @ 157'
Drlg. 735'
- 6/17 13" @ 900'
Drlg. 1660'
- 6/24 10" @ 1680'
KC 2145'
8" @ 2315'
Drlg. 2490'
- 7/2 Miss. 2593'
7" @ 2596'
50 qts.
Pump 30 Pot
38.0 Gr.
TD 2616'

COMPLETED

Map No. _____ Sec. 22 Twp. 25 R. 4E

Well No. 4 Eaton "A"

E. Adair et al. Company

FIRST REPORT

Contractor

SE NW SE

SECTION PLAT

990 Ft. from N. Line

_____ Ft. from S. Line

_____ Ft. from E. Line

990 Ft. from W. Line

Butler County

Location X

Rig up _____

Drilling and Remarks:

RECORD

Cased _____ in., _____ ft.

Sand _____

Gas _____

Oil _____

Total Depth _____

PRODUCTION

1st 24 hrs. Nat. _____

1st 24 hrs. after shot _____

Gas _____ Cu. Ft.

Dry Hole _____

Abandoned _____

Date

MAY 28 1947 19

S. J. LEWIS Scout

