


Section 22 Township 25 Range 1EWell No. #5 Eaton "A"Company Franco Central & Eldorado

Miscellaneous NORTH

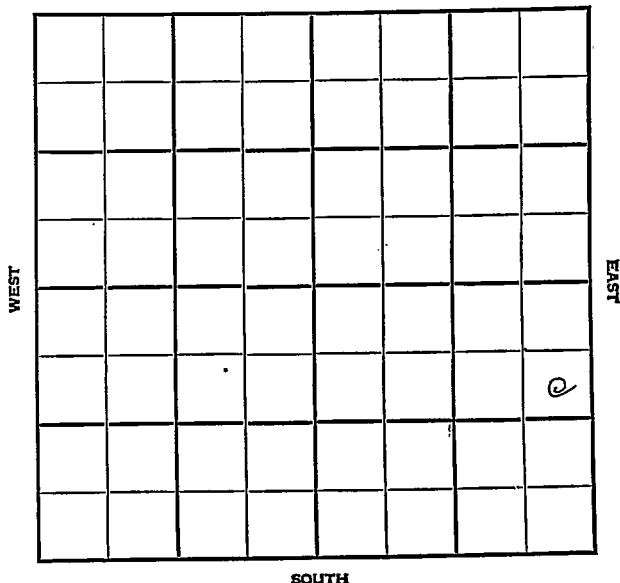

KANSAS


Butler

Sec. 22 Twp. 25 R. 4EWell No. #5 Eaton "A" Farm- Franco Central & Eldorado Company

Miscellaneous

990' Ft. from N. Line Ft. from S. Line330' Ft. from E. Line Ft. from W. Line

SE NE SE

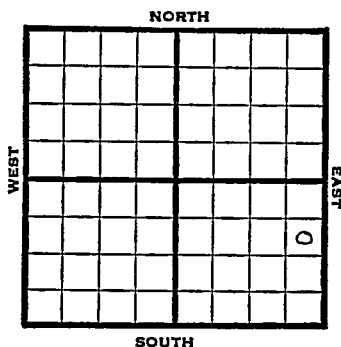

1948

Elev. 1380' REPORT

3/31 Location

4/7 Machine.

4/14 Drlg. 700'

4/21 13" @ 156'
12" @ 840'
Drlg. 1610'

4/28 Drlg. 2398'

5/5 Mississippi 2608'
TD 2610'
5" @ 2608'
RUST5/12 Miss. 2608'
5" @ 2608'
Pump 50 oil Pot
TD 2610'
Comp.

COMPLETED

Map No. _____ Sec. 22 Twp. 25 R. 4EWell No. 5 Eaton "A"Franco Central & Eldorado Company**FIRST REPORT**

Contractor _____

SE NE SE


SECTION PLAT

990 Ft. from N. Line

_____ Ft. from S. Line

330 Ft. from E. Line

_____ Ft. from W. Line

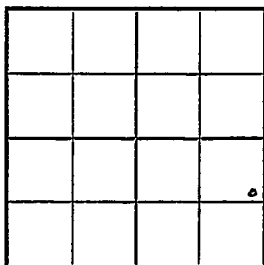Butler CountyLocation X

Rig up _____

Drilling and Remarks: _____

RECORD

Cased _____ in., _____ ft.

Sand _____

Gas _____

Oil _____

Total Depth ^{ft.} _____

PRODUCTION -

1st 24 hrs. Nat. _____

1st 24 hrs. after shot _____

Gas _____ Cu. Ft.

Dry Hole _____

Abandoned _____

Date

MAR 31 1948 19 S. J. LEWIS Scout

Map No. 14 Sec. 22 Twp. 25 R. 4EWell No. 5 Eaton "A"Franco Central & Eldorado Company**COMPLETE**

Contractor

SE NE SE

E1, 1380
SECTION PLAT990 Ft. from N. Line Ft. from S. Line330 Ft. from E. Line Ft. from W. Line

			0

Butler CountyLocation Rig up

Drilling and Remarks:

Miss 2608.5' @ 2608.Pump 50 oil 2608.**RECORD**Cased in., ft.Sand Gas Oil ✓ Total Depth 2610**PRODUCTION**1st 24 hrs. Nat. 1st 24 hrs. after shot Gas Cu. Ft.Dry Hole Abandoned

Date

MAY 12 1948

19

S. J. LEWIS

Scout