


Section.....16.....Township.....17.....Range.....14-W

Well Number.....#1 Lucas.....

Company.....Vickers Pet.....

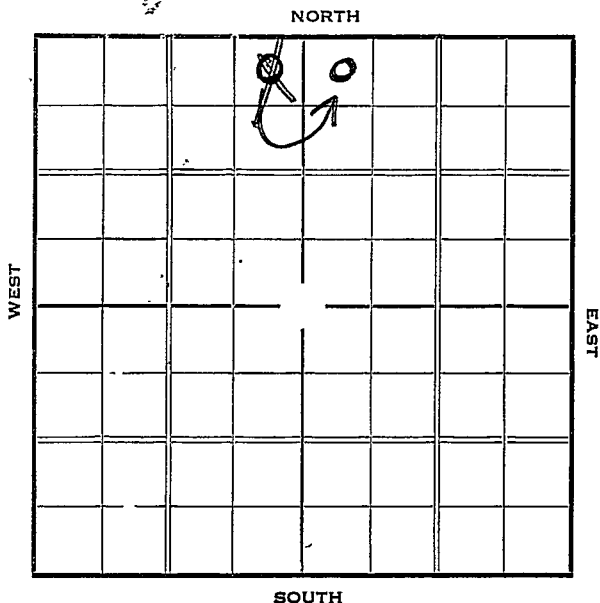

KANSAS

Barton

Sec. 16 Twp. 17 R. 14-N

Well No. #1 Lucas Farm

Vickers Pet. Company


330 Ft. from N. Line

Ft. from S. Line

~~330~~ Ft. from E. Line

330 Ft. from W. Line

Special

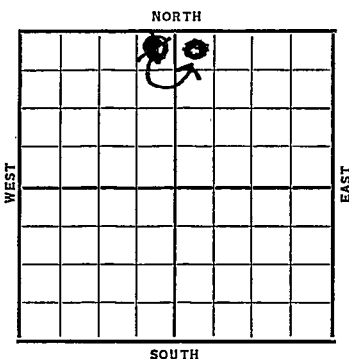[illegible]

1937

9/22 Sil. 3457'.

T.D. 3482'.

H.F.W.

COMPLETED

Barton KANSASMap No. 73 Sec. 16 Twp. 17 R. 14^WWell No. 1-LucasVickers Pet CompanyEmpire Farm-Oil Contractor

FIRST REPORT

SECTION PLAT

330 Ft. from N. Line Ft. from S. Line330 Ft. from E. Line Ft. from W. Line

Special

	0		

Location Rig up

Drilling and Remarks:

mat.

RECORD

Cased in., ft.Sand Gas Oil Total Depth

PRODUCTION

1st 24 hrs. Nat. 1st 24 hrs. after shot Gas Cu. Ft.Dry Hole Abandoned

Date

JUN 30 1937 19 H. D. Hatfield Scout

Barton KANSASMap No. 73 Sec. 16 Twp. 17 R. 14^WWell No. 1-Lucas
Vickers Pet. Company

Contractor

CORRECTION

330 Ft. from N. Line

_____ Ft. from S. Line

_____ Ft. from E. Line

330 Ft. from W. Line

SECTION PLAT

		0	

Location _____

Rig up _____

Drilling and Remarks:

*Loc given out
incorrectly.**was NENW*

RECORD

Cased _____ in., _____ ft.

Sand _____

Gas _____

Oil _____

Total Depth _____

PRODUCTION

1st 24-hrs. Nat. _____

1st 24 hrs. after shot _____

Gas _____ Cu. Ft.

Dry Hole _____

Abandoned _____

Date

JUL 7 1937

19

H. D. Hatfield

Scout

KANSAS

Map No. _____ Sec. 16 Twp. 17 R. 14WWell No. 1-LucasVickers petroleum Company

Contractor _____

SECTION PLAT

		0	

330 Ft. from N. Line

_____ Ft. from S. Line

_____ Ft. from E. Line

330 Ft. from W. Line

ABANDONED

Location _____

Rig up _____

Drilling and Remarks:

H. F. W.N + H

RECORD

Cased _____ in., _____ ft.

Sand 3457

Gas _____

Oil _____

Total Depth 3482

PRODUCTION

1st 24 hrs. Nat. _____

1st 24 hrs. after shot _____

Gas _____ Cu. Ft.

Dry Hole _____

Abandoned _____

Date

SEP 22 1937

19

H. D. Hatfield

Scout