


Section 22 Township 25 Range 4E

Well No. 3 Loving

Company Eldorado Ref. etal

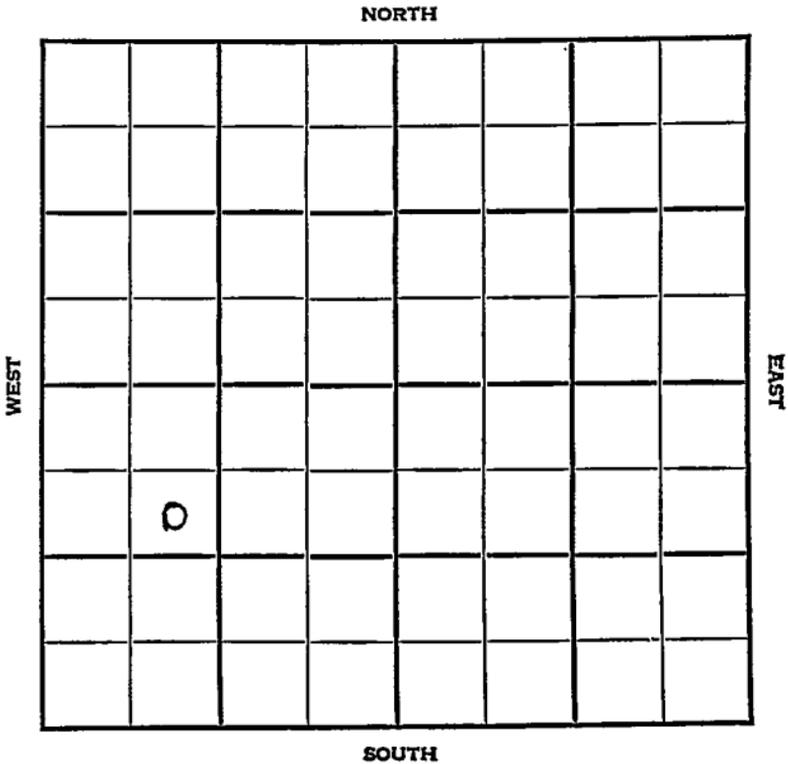

Sec. 22 Twp. 25 R. 4E

Well No. #3 Loving Farm

Eldorado Ref. et al Company


Misc.

990 Ft. from N. Line

_____ Ft. from S. Line

_____ Ft. from E. Line

990 Ft. from W. Line

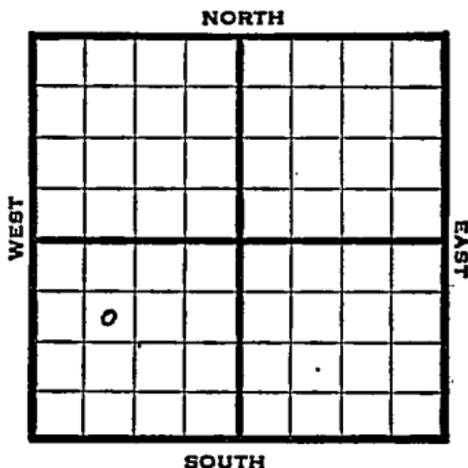

SE NW SW

1947 Elev. 1370' REPORT

- 12/23 Location
- 12/30 Machine
- 1948
1/7 Spud.
- 1/14 15" @ 194'
Drlg 485'
- 1/21 12" @ 895'
Drlg. 1090'
- 1/26 10" @ 1698'
Lansing 1860'
Drlg 1950'
- 2/4 Miss. 2571'
TD 2574'
7" @ 2571'
RUST
- 2/111 Miss. 2571'
7" @ 2571'
25 qts. 2576-89'
Pump 50 Pot
Gr. 38.0
TD 2589'
Comp.

COMPLETED

Map No. _____ Sec. 22 Twp. 25 R. 4E

Well No. 3 Loving

_____ Eldorado Ref. etal. _____ Company

_____ **FIRST REPORT** _____ Contractor

SE NW SW

SECTION PLAT

990 Ft. from N. Line

_____ Ft. from S. Line

_____ Ft. from E. Line

990 Ft. from W. Line

Butler County

Location X

Rig up _____

Drilling and Remarks:

RECORD

Cased _____ in., _____ ft.

Sand _____

Gas _____

Oil _____

Total Depth _____

PRODUCTION

1st 24 hrs. Nat. _____

1st 24 hrs. after shot _____

Gas _____ Cu. Ft.

Dry Hole _____

Abandoned _____

Date

DEC. 23 1947 19

S. J. LEWIS Scout

