

Section 17 Township 17 Range 11WWell No. #1 BoyleCompany W.J. Coppinger et al

NORTH

							0

WEST

EAST

SOUTH

8

Barton KANSAS

SEC. 17	TWP. 17	R. 11 W
---------	---------	---------

WELL NO. # 1 Boyle FARM

COMPANY W. J. Coppinger et al

CONTRACTOR

Coppinger Tools
Wildcat


_____ Ft. from N. Line

990 _____ Ft. from S. Line

330 _____ Ft. from E. Line

_____ Ft. from W. Line

NE SE NE

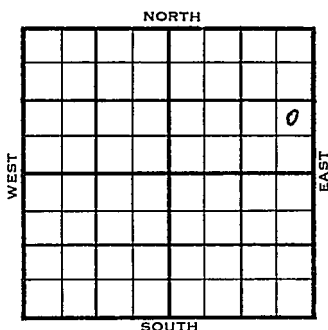


Phillips BHM. & DHM

1954	ELEVATION 1951'	REPORT
------	--------------------	--------

9/15	Location
12/22	Spud 9-18-54 Oil Well TD 3459' 8" @ 260' Anhy 930', Heeb 3122' Tor 3137' Br. Lime 3188', Lans 3199' BKC 3404' Cong 3410', Arb. 3443' DST 3445'-50' opn $\frac{1}{2}$ hr, rec 8' Mud 585# Reagan Sd. 3454' DST 3450'-59' opn 1 hr, rec 675' oil 500' gas, 8 40# TD 3459' 5" @ 3450' CO to 3459' FU 760' oil S/ 6 boph 3 hr P/ 50 bopd. 8 days P/ 99 bo 24 hr. Comp 25 bopd. 33% Wtr.

COMPLETED

FABEN GILSTRAP

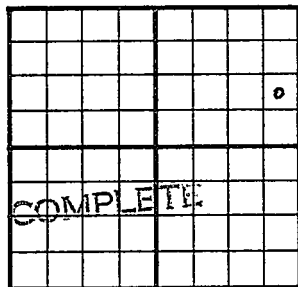County Barton State KansasSec. 17 (Blk. Twp.) 17 (Sur. Rge.) 14W Map No.Operator W. J. Coppinger et al.Well No. 1 Farm BoyleElev. 1951 Location NE SE NE990 Ft. From S Line NE330 Ft. From E Line Quarter

1st. Report

Completion DEC 22 1954Remarks WildcatCoppinger - Contr.Spudding Date 9-18-54Drig. Data Oil well TD 3459

8" @ 260 Anhy 930 Heeb. 3122

Tor. 3137 Br. lime 3188 Lans. 3199

B KC 3404 Cong 3410 Arb. 3443

DST 3445-50 open $\frac{1}{2}$ hr. Rec. 8' mud

585# Reagan sd. 3454 DST 3450-59

open 1 hr. Rec. 675' oil 500' gas

840# TD 3459 5" @ 3450 CO to 3459

FU 760' oil S/ 6 boph 3 hr.

P/ 50 bopd 8 days P/ 99 bo 24 hr.

Comp. 25 bopd 33% wtr.

FABEN GILSTRAP