

KANSAS


FORM 51 IOM 12-46 PETROL

Butler

Section 22 Township 25 Range 4-E

Well No. #2 Fisk

Company E. Adair

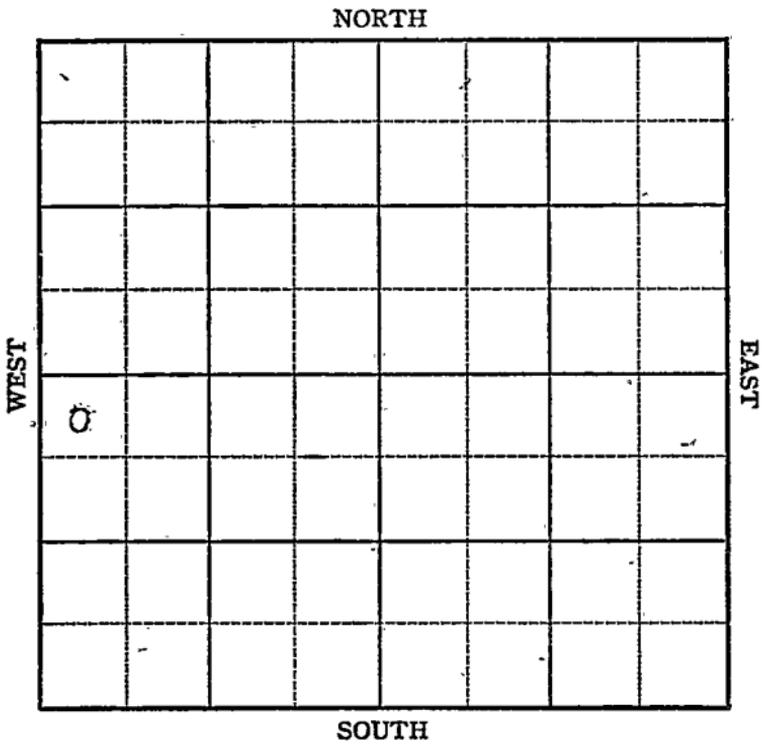

Sec. 22 Twp. 25 R. 4-E

Well No. #2 Fisk Farm _____

E. Adair Company _____


Miscellaneous

330 Ft. from N. Line

_____ Ft. from S. Line

_____ Ft. from E. Line

330 Ft. from W. Line

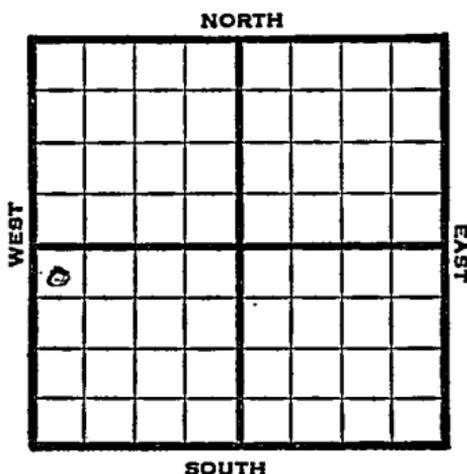

NW SW

1947 1353 REPORT

- 2/19 Machine
- 2/26 15" @ 150'
Drlg 650'
- 3/4 Drlg 1650'
- 3/11 Drlg 2030'
- 3/18 Miss 2562'
TD 2565'
7" @ 2562'
WOC
- 3/25 TD 2587' W PB
- 4/2 PB 2575 Swb 30 bbls oil a day
- 4/9 " " "
- 4/15 " " "
- 4/23 1 " " 2633' " "
- 4/29 1 " " " " "
- 5/7 Miss. 2562
7" @ 2562
Pump 20 Pot
Grav. 38
TD 2587'

COMPLETED

Map No. 14 Sec. 22 Twp. 25 R. 4EWell No. 2 FiskE. Adair Company

FIRST REPORT

Contractor

NW SW

SECTION PLAT

330 Ft. from N. Line Ft. from S. Line Ft. from E. Line330 Ft. from W. Line

o			

Butler County

Location Rig up

Drilling and Remarks:

Machine

RECORD

Cased in., ft.Sand Gas Oil Total Depth

PRODUCTION

1st 24 hrs. Nat. 1st 24 hrs. after shot Gas Cu. Ft.Dry Hole Abandoned

Date

FEB 19 1947

19

S. J. LEWIS

Scout

