

DX 78-1


Section 16 Township 17 Range 14WWell No. 14 DrydenCompany Rocket Drilg. et al

NORTH

WEST

EAST

SOUTH

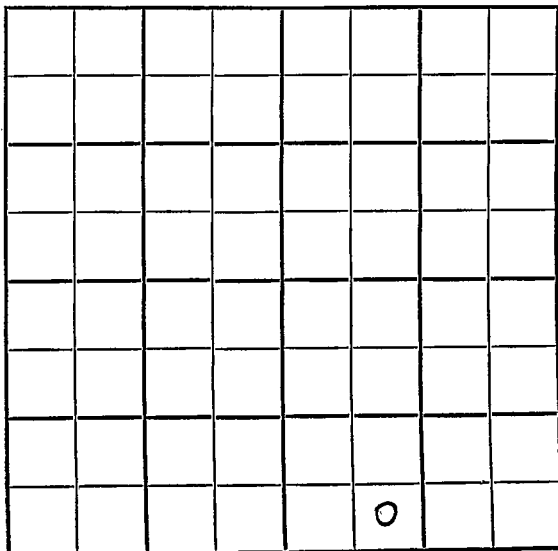

Barton KANSAS

SEC.	16	TWP.	17 $\frac{1}{2}$	R.	14W
WELL NO.					
4 Dryden					
COMPANY					FARM
Rocket Drlg. et al					
CONTRACTOR					
Rocket Drlg.					

Carroll Pool

Ft. from N. Line


330

Ft. from S. Line

Ft. from E. Line

990

Ft. from W. Line

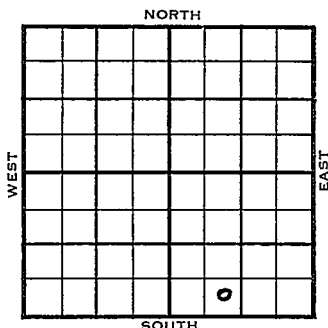

SE SW SE

	ELEVATION	REPORT
1954	1899'	

7/7	Spudding 7-2-54 8" @ 616 Anhy 872 Drlg. 2485
7/14	Spud 7-2-54 D&A TD 3431' 8" @ 616' Anhy 872', Heeb 3064', Br lime 3131', Lans 3141' DST 3134'-63', opn 1 hr., rec. 100' wtr, 560# B KC 3356', Cong 3367', Cherty Arb. 3388' DST 3282-3401', opn 1 hr., rec. 61' mud 650# Arb. 3412' TD 3431' D&A

ABANDONED

County Barton State Kansas

Sec. 16 (Blk. Twp.) 17 (Sur. Rge.) 14W Map No.

Operator Rocket Drig. etal.

Well No. **4** Farm **Dryden**

Elev.	Location	SE SW SE
-------	----------	----------

FIRST REPORT

330 Ft. From **S** Line **SE**

990 Ft. From IV Line Quarter

1st. Report JUL 7 1954

Completion

Remarks

Rocket Drlg. - Contr.

Spudding Date **7-2-54**

Drq. Data

8" @ 616 Anhy 872 drlg. 2485

J. G. McGEHEE

County Barton State Kansas
 Sec. 16 (Blk. Twp.) 17 (Sur. Rge.) 14W Map No. _____
 Operator Rocket Drlg. etal.
 Well No. 4 Farm Dryden
 Elev. 1899 Location SE SW SE



330 Ft. From S Line SE.
990 Ft. From W Line Quarter
 Ist. Report _____
 Completion JUL 14 1954
 Remarks Carroll Pool
Rocket Drlg. - Contr.
 Spudding Date 7-2-54

Drlg. Data D & A TD 3431
8" @ 616 Anhy 872 Heeb. 3064
Br. lime 3131 Lans. 3141 DST 3134-63
open 1 hr. Rec. 100' wtr. 560#
B KC 3356 Cong. 3367 Cherty Arb. 3388
DST 3282-3401 open 1 hr. Rec. 61' mud
650# Arb. 3412 TD 3431

D & A

J. G. McGEHEE