


KANSAS Butler

Section 22 Township 25 Range 4E

Well No. 2 Eaton "A"

Company Ed Adair

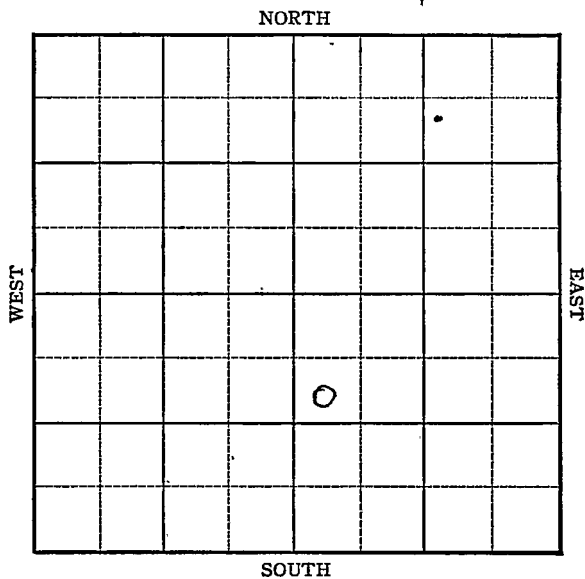



Sec. 22 Twp. 25 R. 4E

Well No. #2 Eaton "A" Farm

Ed Adair Company


Miscellaneous

990 Ft. from N. Line

Ft. from S. Line

Ft. from E. Line

330 Ft. from W. Line

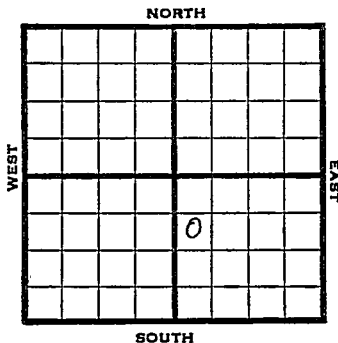

SW NW SE

1946

Elev. 1362

REPORT

- 6/5 Mach.
- 6/12 Spud
- 6/18 15" @ 1060'
Drlg 1105'
- 6/26 1665' Run 10"
- 7/4 KC 2130
8" @ 2340
Drlg 2500'
- 7/9 Miss 2581
TD 2599
7" @ 2581 RUST
- 7/17 Miss. 2581
7" @ 2581
TD 2599
Pump 50 Pot.
Grav. 38.0

COMPLETED

KANSAS

Kansas Pool Name Miscellaneous

Map No. 14 Sec. 22 Twp. 25 R. 4E

Well No. 2 Eaton "A"

Ed Adair Company

FIRST REPORT Contractor

SW NW SE

SECTION PLAT

990 Ft. from N. Line

_____ Ft. from S. Line

_____ Ft. from E. Line

330 Ft. from W. Line

		o	

Butler County

Location _____

Rig up _____

Drilling and Remarks:

Mach.

RECORD

Cased _____ in., _____ ft.

Sand _____

Gas _____

Oil _____

Total Depth _____

PRODUCTION

1st 24 hrs. Nat. _____

1st 24 hrs. after shot _____

Gas _____ Cu. Ft.

Dry Hole _____

Abandoned _____

Date

JUN 5 1946 19. _____

S. J. LEWIS Scout

KANSAS

Kansas Pool Name MiscellaneousMap No. 14 Sec. 22 Twp. 25 R. 4EWell No. 2 Eaton "A"Ed Adair Company**COMPLETED**

Contractor

SW NW SE

E 11362
SECTION PLAT990 Ft. from N. Line Ft. from S. Line Ft. from E. Line330 Ft. from W. Line

		0	

Butler County

Location _____

Rig up _____

Drilling and Remarks:

*Miss 2581**7" @ 2581**Pump 50 P.D.**38° W***RECORD**

Cased _____ in., _____ ft.

Sand _____

Gas _____

Oil _____

Total Depth 2599**PRODUCTION**

1st 24 hrs. Nat. _____

1st 24 hrs. after shot _____

Gas _____ Cu. Ft.

Dry Hole _____

Abandoned _____

Date

JUL 17 1946 19S. J. LEWIS Scout