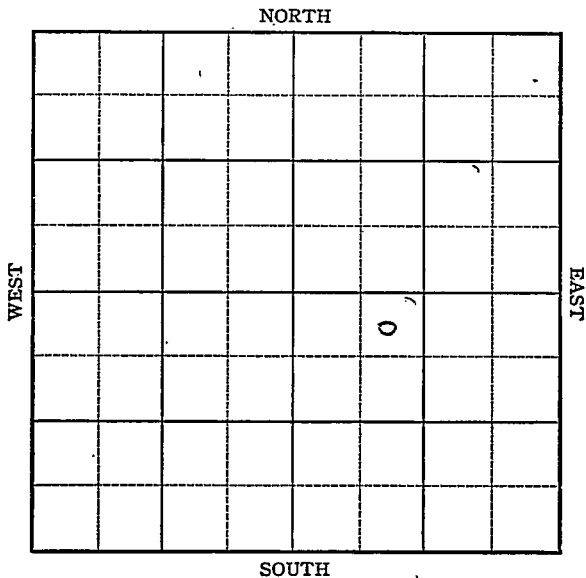


KANSAS

Butler

FORM 51 5M 6-46 PETROL

Section 22 Township 25 Range 4-EWell No. #3 Eaton "A"Company Ed Adair

KANSAS

Butler County



Sec. 22 Twp. 25 R. 4E

Well No. #3 Eaton "A" Farm

Ed Adair Company

Miscellaneous

330

Ft. from N. Line


Ft. from S. Line

Ft. from E. Line

990

Ft. from W. Line

NE NW SE

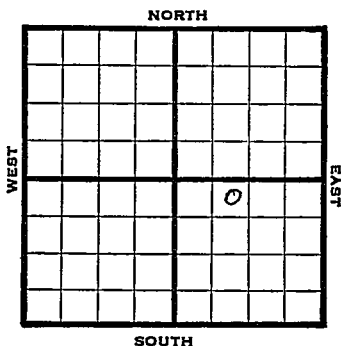

1946 Elev. 1378' REPORT

8/21 Machine
8/27 15" @ 155
Drlg 670'
9/5 13" @ 925'
1690 Run 10"
9/10 Lans 1845'
KC 2150
8" @ 2320'
Drlg 2420'
9/18 Miss 2610
6" @ 2592'
TD 2624-1710' oil
9/25 Miss 2610'
6" @ 2592'
TD 2624
Pump 25-oil plus 10% W POT
Grav 40

COMPLETED

Kansas Pool Name MiscellaneousMap No. 14 KANSAS Sec. 22 Twp. 25 R. 4EWell No. 3 Eaton "A"Ed Adair CompanyFIRST REPORT Contractor

NE NW SE

SECTION PLAT

		o	

330 Ft. from N. Line Ft. from S. Line Ft. from E. Line990 Ft. from W. LineButler CountyLocation Rig up

Drilling and Remarks:

Machine

RECORD

Cased in., ft.Sand Gas Oil Total Depth

PRODUCTION

1st 24 hrs. Nat. 1st 24 hrs. after shot Gas Cu. Ft.Dry Hole Abandoned

Date

AUG 21 1946 19S. J. LEWIS Scout

KANSAS Kansas Pool Name MiscellaneousMap No. 14 Sec. 22 Twp. 25 R. 4EWell No. 3 Eaton "A"Ed Adair Company**COMPLETED**

NE NW SE

Contractor

E 11/378
SECTION PLAT330 Ft. from N. Line Ft. from S. Line Ft. from E. Line990 Ft. from W. Line

		0	

Butler CountyLocation Rig up

Drilling and Remarks:

Mies 26106" 02592Pump 35 oil10 1/2 W 20 1/240 = 92**RECORD**Cased in., ft.Sand Gas Oil Total Depth 2624**PRODUCTION**1st 24 hrs. Nat. 1st 24 hrs. after shot Gas Cu. Ft.Dry Hole Abandoned

Date

SEP 25 1946

19

S. J. LEWIS

Scout