


Section 22 Township 25 Range 4E

Well No. 6 Eaton "A"

Company Franco Central et al

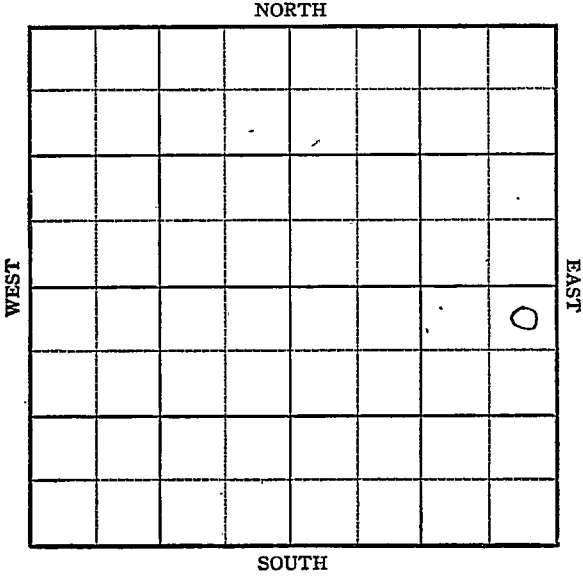



Sec. 22 Twp. 25 R. 4E

Well No. #6 Eaton "A" Farm

Franco Central et al Company

Miscellaneous


330' Ft. from N. Line

_____ Ft. from S. Line

330' Ft. from E. Line

_____ Ft. from W. Line

NE SE

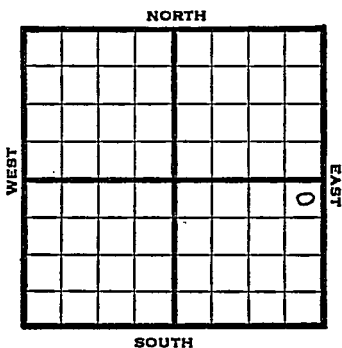

1948

Eli 1590' REPORT

7/28

Machine

8/4

15" @ 100'
Drlg. 160'

8/11

13" @ 820'
Drlg 1350'

8/18

10" @ 1480'
Lansing 1885'
Drlg 1905'

8/25

KC 2170
8" @ 2390'
Mississippi 2623'
TD 2625

9/1

7" @ 2623'
Miss 2623'
7" @ 2623'
TD 2632'
Aband.

ABANDONED

Butler County Kansas State

Map No. _____ Sec. 22 Twp. 25 R. 4E

Well No. 6 Eaton "A"

FrancoCentral etal. Company

FIRST REPORT

Contractor

NE SE

SECTION PLAT

							o

330 Ft. from N. Line

_____ Ft. from S. Line

330 Ft. from E. Line

_____ Ft. from W. Line

Miscellaneous

Remarks:

Machine

Date APR 28 1948

Scout S. J. LEWIS

Butler County Kansas State

Map No. 14 Sec. 22 Twp. 25 R. 4E

Well No. 6 Eaton "A"

Franco Central etal. Company

ABANDONED

Contractor

NE SE

E. 1, 1890

SECTION PLAT

330 Ft. from N. Line

_____ Ft. from S. Line

330 Ft. from E. Line

_____ Ft. from W. Line

Miscellaneous

Remarks:

Miss 2623

7" @ 2623

7" @ 2632

Scout S. J. Lewis

1948

Butler County Kansas

Section Plat

6 Eaton "A"

Abandoned

Contractor

Franco Central et al.

Date
SEP 1 1948

Scout **S. J. LEWIS**