


Section 27 Township 32 Range 5-E

Well No. #2 Eninger

Company Gralapp

NORTH Miscellaneous

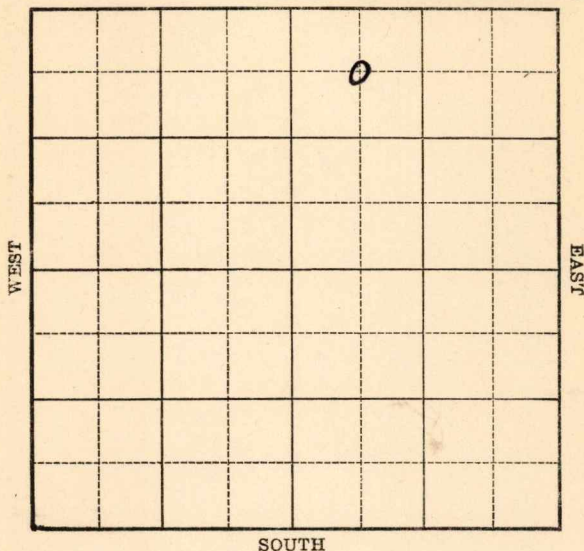


KANSAS

Cowley

Sec. 27 Twp. 32 R. 5-EWell No. #2 Elinger FarmGralapp Company

(Miscellaneous)

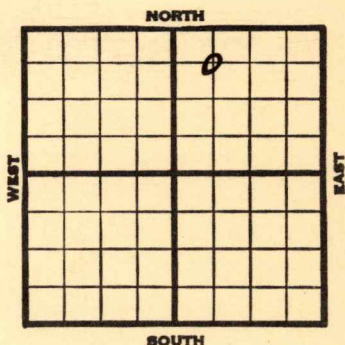660 Ft. from N. Line Ft. from S. Line Ft. from E. Line660 Ft. from W. Line

1939

REPORT

10/25

6" - 400'

Gas 638-44'

T.D. 650'

Est. 1/2 M gas.

220# rock pressure.

FIRST REPORT

and

COMPLETED

Cowley

KANSAS

Map No. 2 Sec. 27 Twp. 32 R. 5EWell No. 2 ElingerGralapp

Company

FIRST REPORT
COMPLETED

Contractor

C NW NE

SECTION PLAT

		o	

660 Ft. from N. Line Ft. from S. Line Ft. from E. Line660 Ft. from W. Line

MISCELLANEOUS

Location Rig up

Drilling and Remarks:

6" - 400

Gas 638-44

T.D. 650

Est. $\frac{1}{2}$ M Gas

220# Rock Pressure

Completed

RECORD

Cased in., ft.Sand Gas Oil Total Depth 650

PRODUCTION

1st 24 hrs. Nat. 1st 24 hrs. after shot Gas Cu. Ft.Dry Hole Abandoned

Date

OCT 25 1939

19

S. J. LEWIS

Scout