

FORM 51

Cowley


KANSAS

O.W.W.O.

Section 28 Township 32 Range 5E

Well No. 1 Stover

Company Lindas Oil

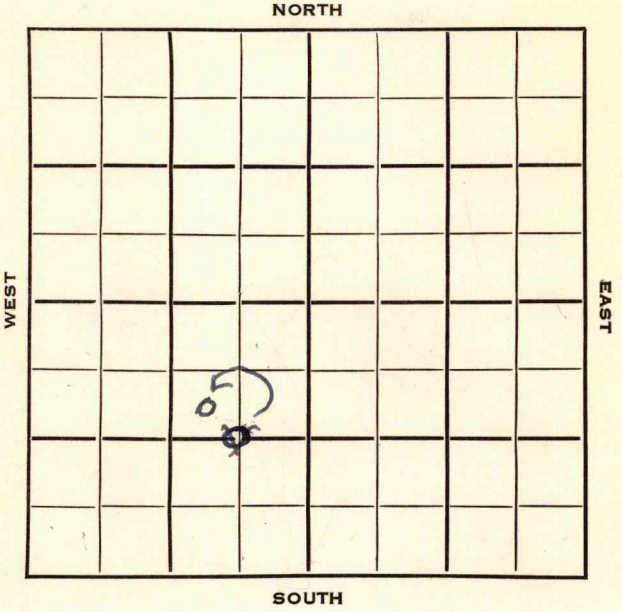

O.W.W.O.

Cowley

KANSAS ✓

Sec. 28 Twp. 32 R. 5 E

Well No. # 1 Stover Farm

Lindas Oil Company

Contractor


990 Ft. from N. Line

~~1320~~ Ft. from S. Line

990
~~660~~ Ft. from E. Line

Ft. from W. Line

SW NE SW
~~6 1/2 SW/4~~

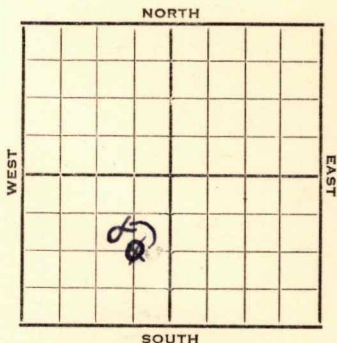

1952 **Elev. 1236'** REPORT

11/26 Spud 11-23-52
8" @ 165

Drig. 950'

12/17 Spud 11-23-52

D&A

TD 3108

8" @ 165

Layton 2366, KC 2522, Oswego
2704', Miss 3075

TD 3108

D&A

ABANDONED

O.W.W.O.

1953
1/21

Layton 2366, KC 2522, Miss 3075

OTD 3108,

To Work Over

4/1 D & A TD 3108' Layton 2366

KC 2522 Miss. 3075 OTD 3108'

CO to 3106 5" @ 3106 PB 3086

55 A CO to 3108 St-frac. S/1/2 BO

1/2 BWPB

D & A

ABANDONED

County **Cowley** State **Kansas**

Sec. **28** (Blk. Twp.) **32** (Sur. Rge.) **5E** Map No.

Operator **Lindas Oil**

Well No. **1** Farm **Stover**

Elev. Location **C E $\frac{1}{2}$ SW/4**

1320 Ft. From **S** Line **SW**

660 Ft. From **E** Line **Quarter**

Ist. Report **NOV 26 1952**

Completion

Remarks

Spudding Date **11-23-52**

Drlg. Data

8" @ 165 drlg. 950

Kansas

Map No. _____ Sec. 28 Twp. 32 R. 5E

Well No. 1 Stover

Lindas Oil Company

CORRECTION

Contractor

SW NE SW

SECTION PLAT

990 Ft. from N. Line

_____ Ft. from S. Line

990 Ft. from E. Line

_____ Ft. from W. Line

	o		

Cowley County

Location _____

Rig up _____

Drilling and Remarks:

RECORD

Cased _____ in., _____ ft.

Sand _____

Gas _____

Oil _____

Total Depth _____

Reported

C E $\frac{1}{2}$ SW $\frac{1}{4}$

PRODUCTION

1st 24 hrs. Nat. _____

1st 24 hrs. after shot _____

Gas _____ Cu. Ft.

Dry Hole _____

Abandoned _____

Date

DEC 3 1952 19

J. G. McGEHEE

Scout

