

Sec. 17 Twp. 17 R. 14W

Well No. #1 Boyle Farm

Yellow Cab Company

Contractor

Ft. from N. Line


330' Ft. from S. Line

Ft. from E. Line

990' Ft. from W. Line

SE SW SE

Sunray Corp

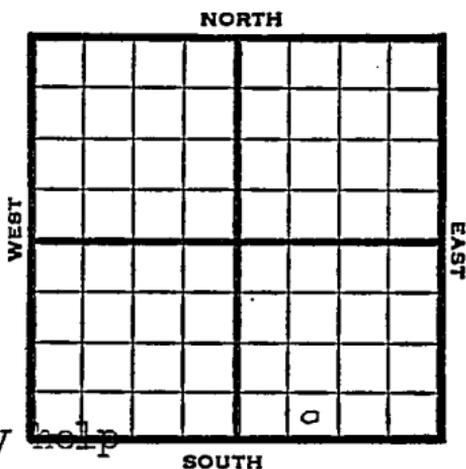

1950 Elev. 1913' REPORT

3/8 Spud 3-3-50
 Anhy 888'
 8" @ 889'
 Drlg. 1675'

4/19 TD 3408'
 Anhy 888'
 8" @ 889'
 Heeb 3084'
 Lans 3157'
 SSO 3171-91
 DST 3171-84'
 Rec 100' wtr.
 Comp
 SSO 3246-62
 SSO 3331-38
 Cong 3376'
 Arb. 3401- so
 5" @ 3402
 TD 3408
 Fill up 1100' oil
 500 acid
 Swab 8 boph
 Comp 321 bopd
 Comp

COMPLETED

Map No. _____ Sec. 17 Twp. 17 R. 14W

Well No. 1 Boyle

Yellow Cab Company

Contractor _____

SE SW SE

Fl. 1913
SECTION PLAT

_____ Ft. from N. Line

330 Ft. from S. Line

_____ Ft. from E. Line

990 Ft. from W. Line



Barton County

Sunray help

Location _____

Rig up _____

Drilling and Remarks:

Spud 3-3-50

Anhy 888

8" @ 889

drlg. 1675

RECORD

Cased _____ in., _____ ft.

Sand _____

Gas _____

Oil _____

Total Depth _____

PRODUCTION

1st 24 hrs. Nat. _____

1st 24 hrs. after shot _____

Gas _____ Cu. Ft.

Dry Hole _____

Abandoned _____

Date

MAR 8 1950

19

J. E. TYRA

Scout

Kansas

Boyle Pool

Map No. _____ Sec. 17 Twp. 17 R. 14W

Well No. L. Boyle

Yellow Cab Company

Contractor

SE SW SE


E. 1913
SECTION PLAT

_____ Ft. from N. Line

330 Ft. from S. Line

_____ Ft. from E. Line

990 Ft. from W. Line

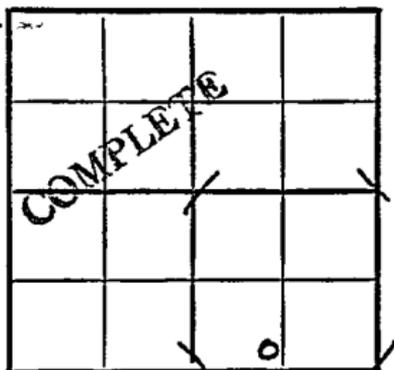

Barton County

Location _____

Rig up _____

Drilling and Remarks:

anky 888
8" c 889
Heel. 3084
Kans. 3157
SSO 3171-91
DST 3171-84
Rec. 100' water

RECORD

Cased _____ in., _____ ft.

Sand _____

Gas _____

Oil _____

Total Depth 3408

PRODUCTION

1st 24 hrs. Nat. _____

1st 24 hrs. after shot _____

Gas _____ Cu. Ft.

Dry Hole _____

Abandoned _____

Date

APR 19 1950 19

J. E. TYRA

Scout

See 3246-62
 " 3331-38
 Cong. 3376
 arb. 3401 *see*
 5" @ 3402
 T.D. 3408
 Fill up 1100' oil
 500 acid
 Swab & bash
 Cong. 321 *Wash*

RECCBT

| | | | |
|--|--|--|--|
| | | | |
| | | | |
| | | | |
| | | | |

APR 28 1958

Scout Cards *Edith*
 Land Small Map
 Land Wall Map *E*
 Tracings
 France Map
 Pierce Map
 Misc.