


DX 78-1 Barton

KANSAS

Section 17 Township 17 Range 11W

Well No. 3 Boyle

Company Coppinger Drlg.

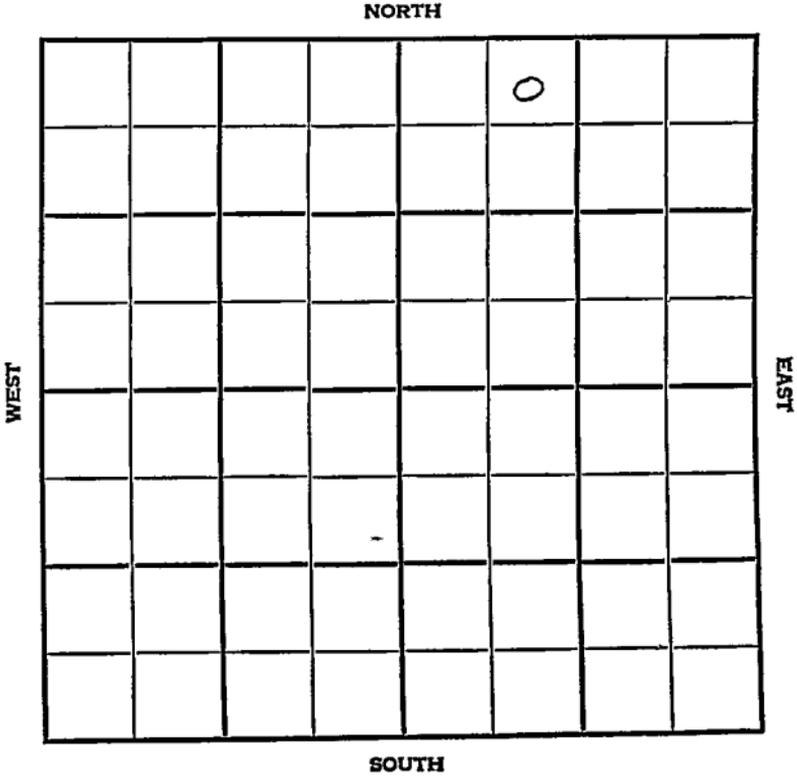

SEC.	17	TWP.	17	R.	14W
------	----	------	----	----	-----


WELL NO. #3 Boyle FARM

COMPANY Coppinger Drlg.

CONTRACTOR

N. Carroll Pool

330 \_\_\_\_\_ Ft. from N. Line  
 \_\_\_\_\_ Ft. from S. Line  
 \_\_\_\_\_ Ft. from E. Line  
 990 \_\_\_\_\_ Ft. from W. Line

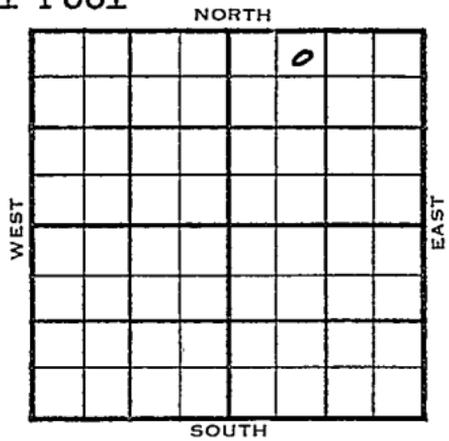

NE NW NE

1955	ELEVATION	REPORT
	1952	
4/27	RUR	
7/27	Comm 5-4-55	
	8 5/8" @620/300 DST 3282-93 open 1 hr.	
	Rec. 5' mud 880# DST 3452-57 open 1hr.	
	Rec. 185' oil 85' vhowm 830# 5 1/2" @	
	3455 DP to 3457 FU 700' oil 8 hr. S/	
	3 1/2 boph S/8 boph 6 hr. 500 A P/40 bopd	
	dec. to 8 bo DD 3458 frac P/15 bo 9 hr	
	DD 3461 1 boph 4 hr. Comp. 14 bopd	
	Anh. 940	
	H. 3127 1175	
	Bl. 3193 1252	
	Dg. 1241	
	L. 3204	
	A. 3454 1502	
	TD. 3457	

COMPLETED



County Barton Elev. 1952

Sec. 17 Twp. 17 Rge. 14W

Company Coppinger Drlg.

Farm Name Boyle No. 3

TOPS	DEPTH	LOG	DATUM
------	-------	-----	-------

Anh.	<u>940</u>		
TP.			
H.	<u>3127</u>		<u>1175</u>
Tr.			
Dg.			<u>1241</u>
BL.	<u>3193</u>		<u>1252</u>
L.	<u>3204</u>		
K.C.			
B.K.C.			
Ce.			
C.			
M.			
M.			
K.			
Mz.			
Me.			
V.			
S.			
S.			
A	<u>3454</u>		<u>1502</u>
R.			
PE.			
G.			
T.D.	<u>3457</u>		

Loc. in Sec. NE NW NE

Geol. \_\_\_\_\_

Contr. \_\_\_\_\_

Pool \_\_\_\_\_

N. Carroll


**COMPLETE**

Date Comm. 5-4-55 JUL 27 1955

8 5/8" @ 620/300 DST 3282-93

open 1 hr. Rec. 5' mud 880#

DST 3452-57 open 1 hr. Rec. 185' oil

85' vhocm 830# 5 1/2" @ 3455

DP to 3457 FU 700' oil 8 hr.

S/ 3 1/2 boph S/ 8 boph 6 hr. 500 A

P/ 40 bopd dec. to 8 bo DD 3458

frac P/ 15 bo 9 hr. DD 3461

**OVER**

1 boph 4 hr. Comp. 14 bopd

.....	Misc.
.....	Plan & M. D.
.....	Forms: D
.....	Trainers
.....	Land Wall Map
.....	Land Small Map
.....	Scout Cards

*[Handwritten signature]*

AUG 4 1956