


Section 17 Township 17 Range 11 W

Well No. # 1 Demel

Company Derby Drlg.

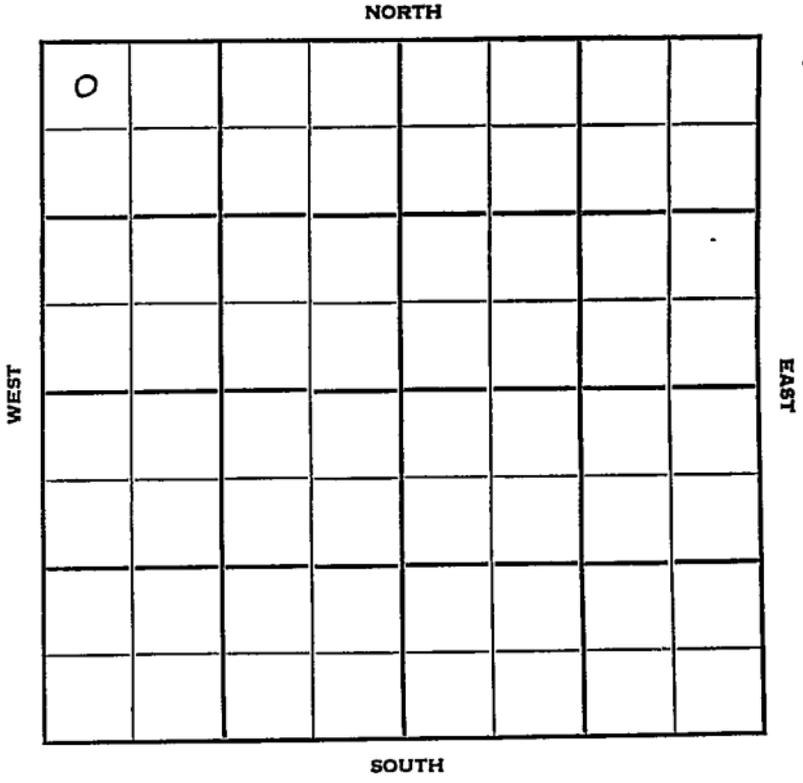

Sec. 17 Twp. 17 R. 14 W ✓

Well No. # 1 Demel Farm

Derby Drlg. Company

Rocket Drlg. Contractor

Semi Wildcat

330 Ft. from N. Line


\_\_\_\_\_ Ft. from S. Line

\_\_\_\_\_ Ft. from E. Line

330 Ft. from W. Line

NW NW NW

C R A Farmout

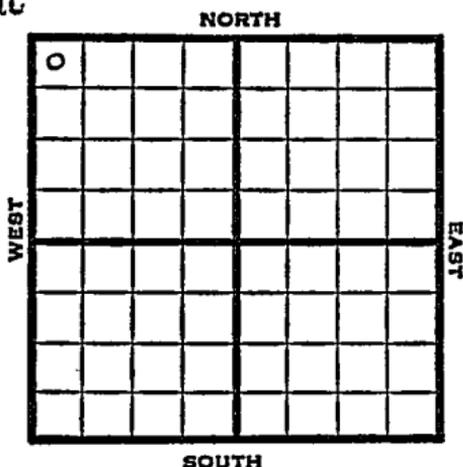

1951 Elev. 1931' REPORT

4/25 Cellar & Pits

5/9 Spud 4-24-51  
 D & A TD 3460' 8" @ 595  
 Anhy 920' Top 2817' Heeb 3109'  
 Tor. 3127' KC 3173'  
 DST 3177-3204' open 1 hr. rec 485' SW  
 DST 3252-70 open 1 hr. rec 60' mud  
 Cong. 3398' Arb. 3448-60' TD  
 D & A

**ABANDONED**

County Barton State Kansas

Sec. 17 (Blk. Twp.) 17 (Sur. Rge.) 14W Map No.

Operator Derby Drlg.

Well No. 1 Farm Dome1

Elev. Location NW NW NW

0							
FIRST REPORT							

330 Ft. From N Line NW

330 Ft. From W Line Quarter

1st. Report APR 25 1951

Completion

Remarks C R A farmout

Rocket Drlg. - Contr.

Spudding Date

Drlg. Data Semi Wildcat

Cellar & pits

J. E. TYRA

County Barton State Kansas

Sec. 17 (Blk. Twp.) 17 (Sur. Rge.) 14W Map No.

Operator Derby Drlg.

Well No. 1 Farm Demel

Elev. 1931 Location NW NW NW

0					

330 Ft. From N Line NW  
330 Ft. From W Line Quarter

1st. Report

Completion MAY 9 1951

Remarks Semi Wildcat

Rocket Drlg. - Contr.

Spudding Date 4-24-51

Drlg. Data D & A TD 3460

8" @ 595 Anhy 920 Top. 2817

Heeb. 3109 Tor. 3127 KC 3173

DST 3177-3204 open 1 hr. Rec. 485' sw

DST 3252-70 open 1 hr. Rec. 60' mud

Cong. 3398 Arb. 3448-60 TD

D & A

J. E. TYRA