


KANSAS
McPherson

Section 6 Township 18 Range 1W

Well No. #2 Crumpacker

Company Westgate-Greenland et al

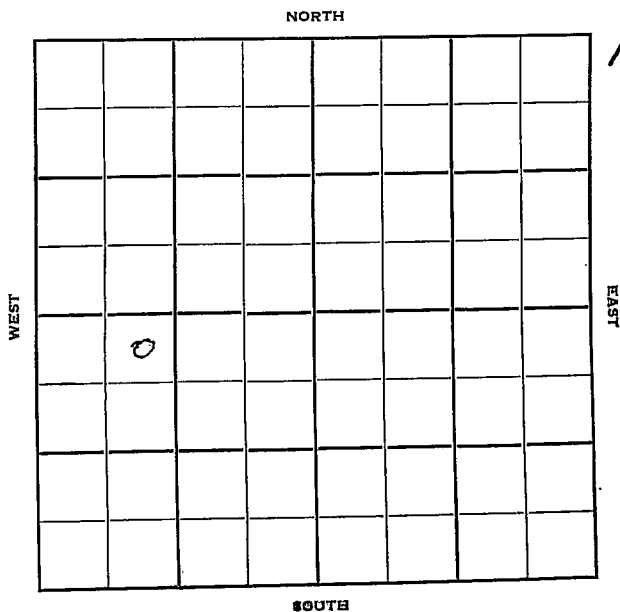

KANSAS McPherson

Sec. 6 Twp. 18 R. 1-W

Well No. #2 Grumpacker Farm
Westgate-Greenland etal Company


330 Ft. from N. Line

 Ft. from S. Line

 Ft. from E. Line

1090 Ft. from W. Line

NE NW SW

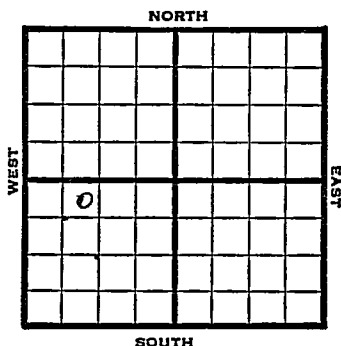

1950

Elev 1442' REPORT

2/22

Spud 2-16-50
8 5/8" @ 131'
Drlg 2327'

4/5

TD 2816'
8" @ 131
Miss 2805'
5 1/2" @ 2806'
286 BOPD
17% Wtr.
Comp

COMPLETED

Kansas

Map No. _____ Sec. 6 Twp. 18 R. 1WWell No. 2 Crumpacker

_____ Westgate-Greenland et al. Company

_____ Contractor

NE NW SW

SECTION PLAT

330 Ft. from N. Line

_____ Ft. from S. Line

_____ Ft. from E. Line

1090 Ft. from W. Line

o			

FIRST REPORT

McPherson County

Location _____

Rig up _____

Drilling and Remarks:

Spud 2-16-50

8 5/8" @ 131

drlg. 2327

RECORD

Cased _____ in., _____ ft.

Sand _____

Gas _____

Oil _____

Total Depth _____

PRODUCTION

1st 24 hrs. Nat. _____

1st 24 hrs. after shot _____

Gas _____ Cu. Ft.

Dry Hole _____

Abandoned _____

Date

FEB 22 1950 19


J. E. TYR

Scout

Kansas

Map No. _____ Sec. 6 Twp. 18 R. 1WWell No. 2 Crumpacker_____Westgate-Greenland_____
Company_____
Contractor

NE NW SW

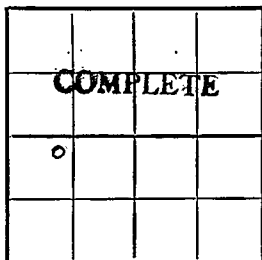El. 1442
SECTION, PLAT330 Ft. from N. Line_____
Ft. from S. Line_____
Ft. from E. Line1090 Ft. from W. Line

McPherson County

Location _____

Rig up _____

Drilling and Remarks:

8" @ 131
Miss 2805
5 1/2 @ 2806
286 BOPD
17% water
c

RECORD

Cased _____ in., _____ ft.

Sand _____

Gas _____

Oil _____

Total Depth 2816

PRODUCTION

1st 24 hrs. Nat. _____

1st 24 hrs. after shot _____

Gas _____ Cu. Ft.

Dry Hole _____

Abandoned _____

Date

APR 5 1950

19

J. E. TYRA Scout