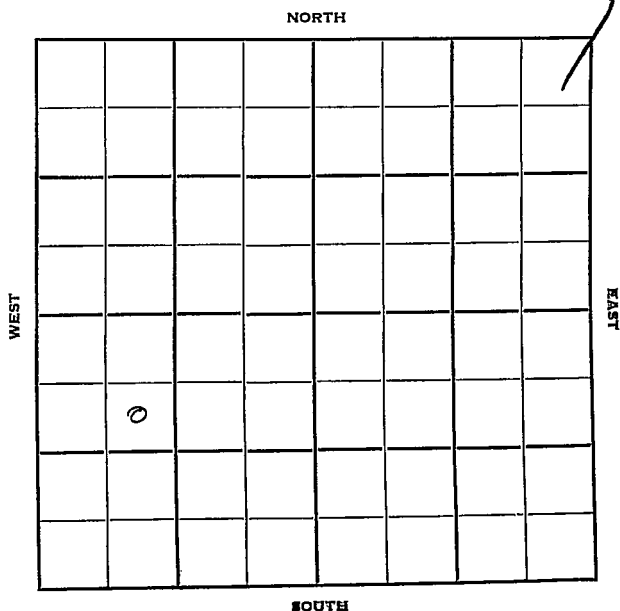


Section 6 Township 18 Range 1-WWell No. #5 CrumpackerCompany Westgate-Greenland

KANSAS

McPherson

Sec. 6 Twp. 18 R. 1-W

Well No. #5 Crumpacker Farm

Westgate-Greenland Company

Jackson Drlg. Contractor

Georob


990 Ft. from N. Line

 Ft. from S. Line

 Ft. from E. Line

990 Ft. from W. Line

SE NW SW

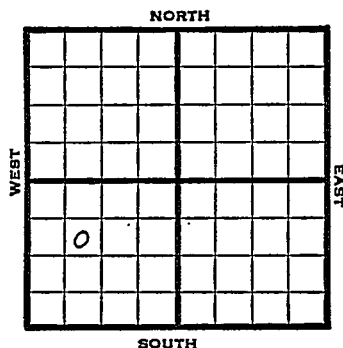


1950 Elev. 1464' REPORT

10/4 MIR

11/22 Spud 10-3-50
Oil Well TD 2832'
8-5/8" @ 136'
Miss 2823' TD 2828'
5" @ 2825' DD 2832
FU 260' oil 16 hr.
1000 A P/18 B0 S/30 bo
3 hr
Comp. 190 bopd 10% wtr.
COMPLETED

J. E. TYRA

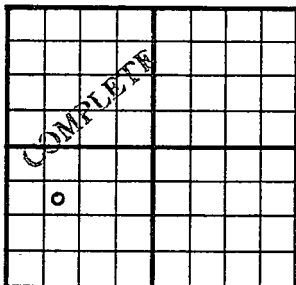County McPherson State KansasSec. 6 (Blk.
Twp.) 18 (Sur.
Rge.) 1W Map No.Operator Westgate-GreenlandWell No. 5 Farm CrumpackerElev. 1464 Location SE 1/4 SW990 Ft. From N Line SW990 Ft. From W Line Quarter1st. ReportCompletion NOV 22 1950Remarks Georob PoolJackson Drlg. - Contr.Spudding Date 10-3-50Drlg. Data Oil well TD 28328 5/8" C 136 Miss. 2823 TD 28285" C 2825 DD 2832 FU 260' oil 16 hr.1000 A P/ 18 bo S/ 30 bo 3 hr.Comp. 190 bohd 10% water

J. E. TYRA