

KANSAS


McPherson

FORM 51 IOM 12-46 PETROL

Section 6 Township 18 Range 1-WWell No. #1 FrisbieCompany Mallard Drlg.

Hoffsomer NORTH

WEST

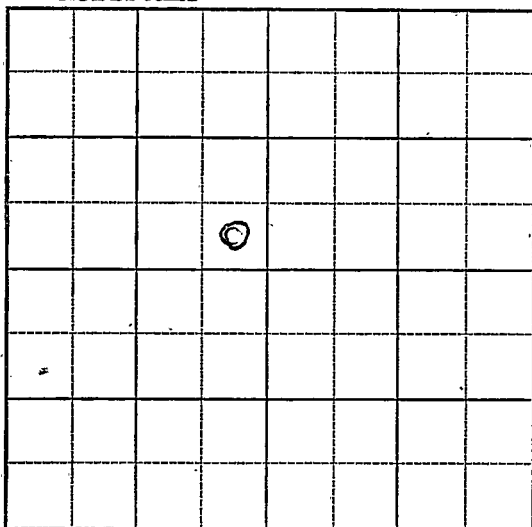

EAST

SOUTH

KANSAS

McPherson County

Sec. 6 Twp. 18 R. 1-W

Well No. 1 Frisbie Farm

Mallard Drlg. Company

Hoffsommer Pool


Ft. from N. Line

330 Ft. from S. Line

330 Ft. from E. Line

Ft. from W. Line

SE NW

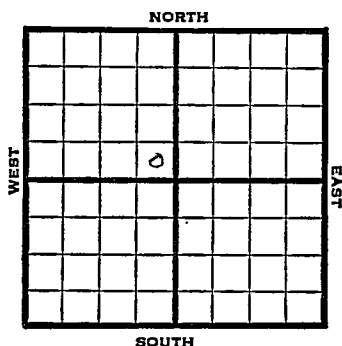

1947

Elev. 1407'

REPORT

8/20 RUR

8/27 Lansing 2810'
Mississippi 2756
TD 2761'
5" @ 2756
RUST

9/3 TD 2774
2000 acid

9/10 Miss. 2708'
5" @ 2758'
2000 acid
Pump 495 oil 1% W Pot
36.0 Gr
TD 2774'


COMPLETED

Kansas

Map No. _____ Sec. 6 Twp. 18 R. 1WWell No. 1 FrisbieMallard Drilling CompanyFIRST DEPT Contractor

SE NW

SECTION PLAT

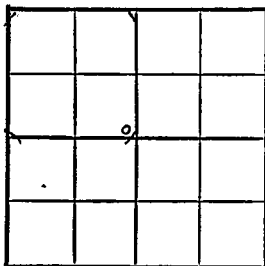

_____ Ft. from N. Line

330 Ft. from S. Line330 Ft. from E. Line

_____ Ft. from W. Line

McPherson County

Location _____

Rig up _____

Drilling and Remarks:

R U R

RECORD

Cased _____ in., _____ ft.

Sand _____

Gas _____

Oil _____

Total Depth _____

PRODUCTION

1st 24 hrs. Nat. _____

1st 24 hrs. after shot _____

Gas _____ Cu. Ft.

Dry Hole _____

Abandoned _____

Date

S. J. LEWIS

AUG 20 1947 19 _____ Scout

Map No. 42 Sec. 6 Twp. 18 R. 1W

Well No: 1 Frisbie

Mallard Drlg.

Company


COMPLETE

Contractor

SE NW

E 11407

SECTION PLAT

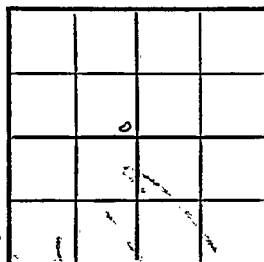

Ft. from N. Line

330 Ft. from S. Line

330 Ft. from E. Line

Ft. from W. Line

McPherson County

Location

Rig up

Drilling and Remarks:

Miss 2708
5" @ 2758
2000 acid
Pump 495 oil
10 W.P. 8"
862 Gr

RECORD

Cased in, ft.

Sand

Gas

Oil

Total Depth 2774

PRODUCTION

1st 24 hrs. Nat.

1st 24 hrs. after shot

Gas Cu. Ft.

Dry Hole

Abandoned

Date

SEP 10 1947 19 S. J. LEWIS Scout