

KANSAS

FORM 51 25M 3-49 PETROLEUM

McPherson

Section 6 Township 18 Range 1W

Well No. 3 Frisbie

Company Westgate-Greenland et al


Hoffsommer

NORTH

WEST

EAST

SOUTH

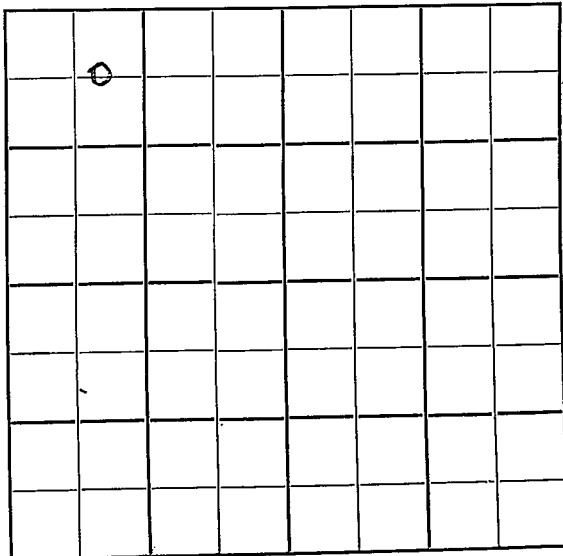

McPherson KANSAS ✓

Sec. 6 Twp. 18-S R. 1W

Well No. #3 Krisbie Farm

Westgate-Greenland et al Company

Hoffsommer Pool (Jackson, Cont.)
660' NORTH


_____ Ft. from N. Line

_____ Ft. from S. Line

_____ Ft. from E. Line

990' Ft. from W. Line

C E L NW NW

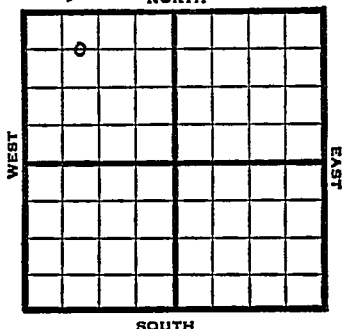

1949

Elev 1390'

REPORT

10/19

8" @ 138'

10/26

Chat 2746'

TD 2748'

5" @ 2748'

11/1

600' oil 2 hrs.

11/9

TD 2749'

Chat 2746'

5" @ 2748'

Pump 268 Oil Pot

39° Gr.

Comp

COMPLETED

Kansas

Map No. _____ Sec. 6 Twp. 18 R. 1WWell No. 3 FrisbieWestgate-Greenland etal. CompanyJackson

Contractor

C E L NW NW

FIRST REPORT
- SECTION PLAT660 Ft. from N. Line Ft. from S. Line Ft. from E. Line990 Ft. from W. Line

o			

McPherson County

Location _____

Rig up _____

Drilling and Remarks: _____

8" @ 138

RECORD

Cased _____ in., _____ ft.

Sand _____

Gas _____

Oil _____

Total Depth _____

PRODUCTION

1st 24 hrs. Nat. _____

1st 24 hrs. after shot _____

Gas _____ Cu. Ft.

Dry Hole _____

Abandoned _____

Date

OCT 19 1949

19

S. J. LEWIS Scout

Kansas

Map No. _____ Sec. 6 Twp. 18 R. 1WWell No. 3 Frisbie

_____ Westgate-Greenland _____ Company

COMPLETE

Contractor

C E L NW NW

E11390
SECTION PLAT660 Ft. from N. Line

_____ Ft. from S. Line

_____ Ft. from E. Line

990 Ft. from W. Line

McPherson County

Location _____

Rig up _____

Drilling and Remarks:

*Chas 2746**5" C 2748**Prod 268 oil**39°*

RECORD

Cased _____ in., _____ ft.

Sand _____

Gas _____

Oil _____

Total Depth 2748

PRODUCTION

1st 24 hrs. Nat. _____

1st 24 hrs. after shot _____

Gas _____ Cu. Ft.

Dry Hole _____

Abandoned _____

Date

NOV 9 1949

19

S. J. LEWIS

Scout