


KANON McPhersonSection 6 Township 18 Range 1WWell No. #4 HoffsommerCompany Westgate-Greenland & Mallard
Hoffsommer

NORTH

WEST

EAST

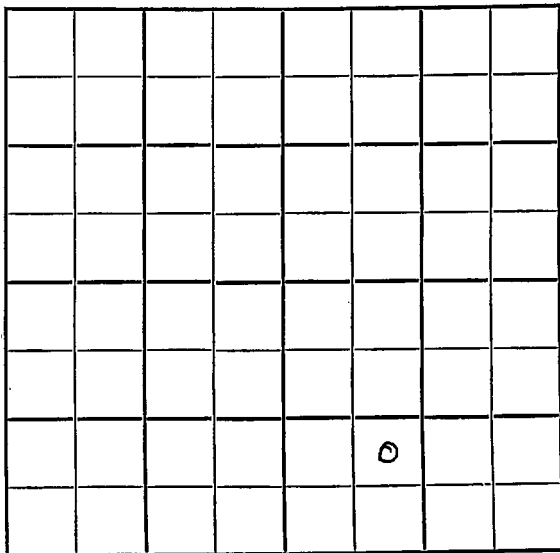

SOUTH

McPherson



Sec. 6 **KANSAS** Twp. 18 R. 1W

Well No. #4 Hoffsommer Farm

Westgate-Greenland & Mallard Company

Hoffsommer


 Ft. from N. Line

990' Ft. from S. Line

 Ft. from E. Line

990' Ft. from W. Line

NE SW SE

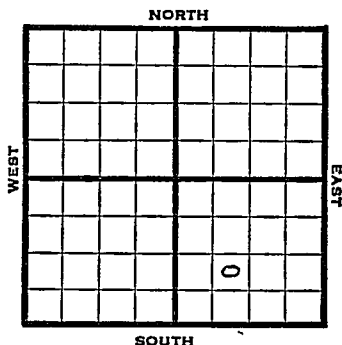

1948 Elev. 1405' REPORT

2/11	Location
2/18	10" @ 145' Drlg 1695'
2/25	Mississippi 2751' TD 2760' 7" @ 2758' RUST
3/3	"
3/10	"
3/17	"
3/24	TD 2776' 2000 Acid
3/31	Miss 2751' 7" @ 2758' 2000 Acid Pump 314 oil / 6% W Pot. Gr. 370 TD 2776'

COMPLETED

Map No. _____ Sec. 6 - - Twp. 18 R. 1W

Well No. 4 Hoffsommer

Westgate-Greenland & Mallen Company

FIRST REPORT

Contractor

NE SW SE

SECTION PLAT

_____ Ft. from N. Line

990 _____ Ft. from S. Line

_____ Ft. from E. Line

990 _____ Ft. from W. Line

McPherson County

RECORD

Location _____ X

Cased _____ in., _____ ft.

Rig up _____

Sand _____

Drilling and Remarks:

Gas _____

Oil _____

Total Depth _____

PRODUCTION

1st 24 hrs. Nat. _____

1st 24 hrs. after shot _____

Gas _____ Cu. Ft.

Dry Hole _____

Abandoned _____

Date

FEB 11 1948

19

S. J. LEWIS

Scout

Map No. 42 Sec. 6 Twp. 18 R. 1W

Well No. 4 Hoffsommer

Westgate-Greenland & Mallard Company

COMPLETE

Contractor

NE SW SE

E 11405
SECTION PLAT

_____ Ft. from N. Line

990 Ft. from S. Line

_____ Ft. from E. Line

990 Ft. from W. Line

		o	

McPherson County

Location _____

Rig up _____

Drilling and Remarks:

*Mud 275!
9" @ 2758.
2000 @ 2758*

*Pump 314 oil + 6 7/8 W
PST*

272 1/2

RECORD

Cased _____ in., _____ ft.

Sand _____

Gas _____

Oil ✓

Total Depth 2776'

PRODUCTION

1st 24 hrs. Nat. _____

1st 24 hrs. after shot _____

Gas _____ Cu. Ft.

Dry Hole _____

Abandoned _____

Date

MAR 31 1948

19

S. J. LEWIS

Scout