

Barton

FORM 51

Section 17 Township 17- Range 14W **KANSAS**

Well No. #4 Boyle

Company Yellow Cab Co.

NORTH

SOUTH

15

EAST

WEST

0

Barton

KANSAS

SEC.

17

TWP.

17

R.

14W



WELL NO.

#4 Boyle

FARM

COMPANY

Yellow Cab Co.

CONTRACTOR

Lewis Drlg.

Boyle Pool

Ft. from N. Line

330

Ft. from S. Line


Ft. from E. Line

330

Ft. from W. Line

SW SW SE

NORTH

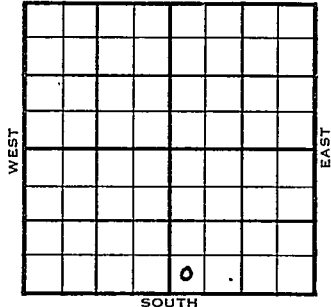

SOUTH

1953

ELEVATION
1898'

REPORT

9/23

Spud 9-15-53

8" @ 881'

Drlg 2944'

9/30

Arb 3382,

RTD 3386

5" @ 3384'

CO 3386

10/7

DD 3390' 10 GOPH 500 A No help

DD 3392' $\frac{1}{2}$ ' TD 500 A S/8 BOPH

POP

10/14

NR

10/21

NR

10/28

"

11/4

Spud 9-15-53 Oil well TD 3394

8" @ 881' Br lime 3144' Lans 3154

B KC 3363 TD 3394 5" @ 3384'

CO to 3386 1000 A FU 750' oil

3 hr. S/8 BOPH

Comp. 75 BOPD

COMPLETED


County Barton State Kansas
 Sec. 17 (Blk. 17) (Sur. 14W) Map No. 14W
 Operator Yellow Cab Co.
 Well No. 4 Farm Boyle
 Elev. 1898 Location SW SW SE

FIRST REPORT

330 Ft. From S Line SE
 330 Ft. From W Line Quarter
 1st. Report SEP 23 1953
 Completion _____
 Remarks Lewis Drlg. - Contr.
 Spudding Date 9-15-53

Drlg. Data. Boyle Pool
8" @ 881 drlg. 2944

J. G. McGEHEE

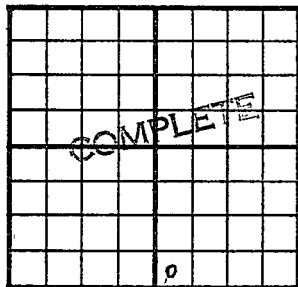County Barton State KansasSec. 17 (Blk.
Twp.) 17 (Sur.
Rge.) 14W Map No.Operator Yellow Cab Co.Well No. 4 Farm BoyleElev. 1898 Location SW SW SE330 Ft. From S Line SE330 Ft. From W Line Quarter1st. ReportCompletion NOV 4 1952Remarks Boyle PoolLewis Drlg. - Contr.Spudding Date 9-15-53Drlg. Data Oil well TD 33948" @ 881 Br. lime 3144 Lans. 3154B KC 3363 TD 3394 5" @ 3384 CO to 33861000 A FU 750' oil 3 hr. S/ 8 bophComp. 75 bopd