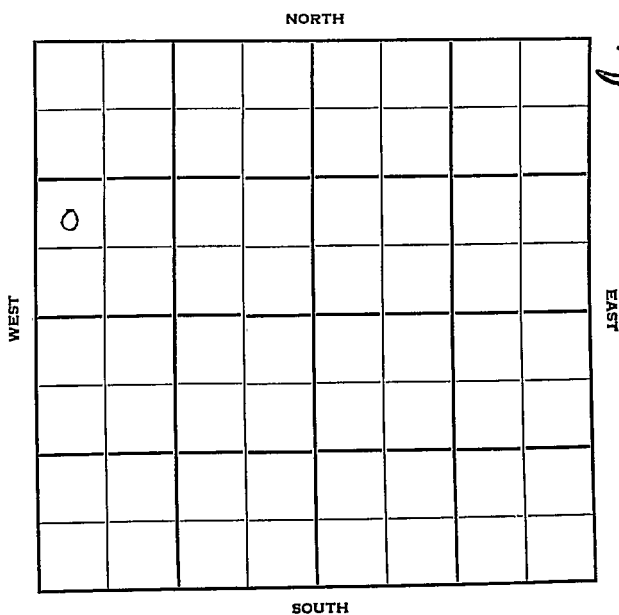


Section 6 Township 18 Range 1WWell No. #5 FrisbieCompany Westgate-Greenland

McPherson

KANSAS

Sec. 6 Twp. 18 R. 1W

Well No. #5 Frisbie Farm

Westgate-Greenland Company

Hoffsommer Pool


 Ft. from N. Line

990' Ft. from S. Line

 Ft. from E. Line

330' Ft. from W. Line

NW SW NW

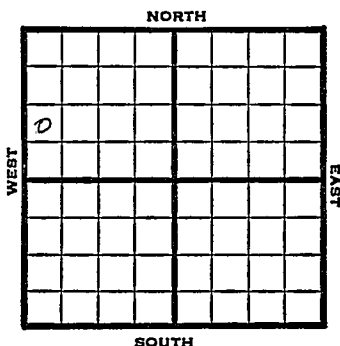

1950 Elev 1402' REPORT

1/18 Spud 1-12-50
8-5/8" @ 125'
Drlg. 1650'

2/22 TD 2785'
8 5/8" set 125'
5" @ 2780'
Chat 2777'
276 BOPD
5% wtr.
Comp

COMPLETED

Kansas

Map No. _____ Sec. 6 Twp. 18 R. 1WWell No. 5 Frisbie_____Westgate-Greenland_____
Company_____
Contractor

NW SW NW

SECTION PLAT

FIRST REPORT			
o			

_____Ft. from N. Line990 Ft. from S. Line_____Ft. from E. Line330 Ft. from W. Line

McPherson County

Location _____

Rig up _____

Drilling and Remarks:

Spud 1-12-50

8 5/8" @ 125

drlg. 1650

RECORD

Cased _____ in., _____ ft.

Sand _____

Gas _____

Oil _____

Total Depth _____

PRODUCTION

1st 24 hrs. Nat. _____

1st 24 hrs. after shot _____

Gas _____ Cu. Ft.

Dry Hole _____


Abandoned _____

Date

JAN 1 8 1950 19J. E. TYRA Scout

Map No. _____ Sec. 6 Twp. 18 R. 1WWell No. 5 Frisbie_____
Westgate-Greenland Company_____
Contractor

NW SW NW

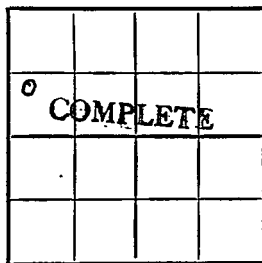E. 1402
SECTION PLAT_____
Ft. from N. Line990 Ft. from S. Line_____
Ft. from E. Line330 Ft. from W. Line

McPherson County

Location _____

Rig up _____

Drilling and Remarks:

*8 5/8 @ 125**5" @ 2780**Chat 2777**276 BOPD**5% water*

RECORD

Cased _____ in., _____ ft.

Sand _____

Gas _____

Oil _____

Total Depth 2785

PRODUCTION

1st 24 hrs. Nat. _____

1st 24 hrs. after shot _____

Gas _____ Cu. Ft.

Dry Hole _____

Abandoned _____

Date

C
FEB 22 1950

19

J. E. TYRA Scout