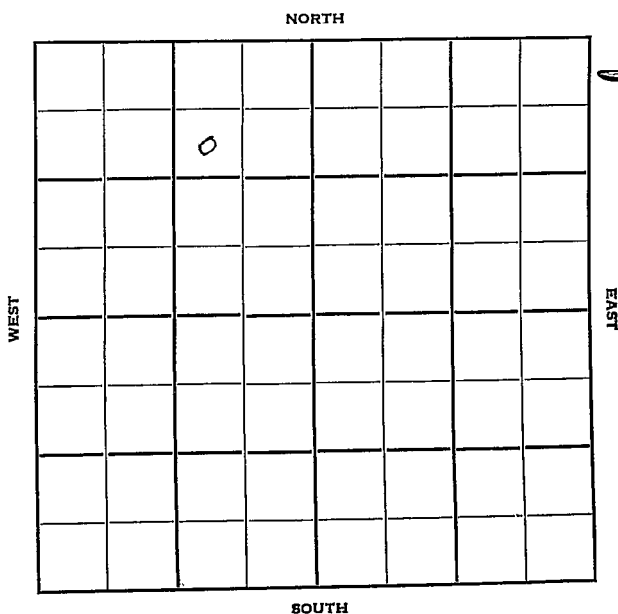


Section 6 Township 18 Range 1WWell No. #6 FrisbieCompany Westgate-Greenland

KANSAS

McPherson ✓

Sec. 6 Twp. 18 R. 1-W

Well No. #6 Frisbie Farm

Westgate-Greenland Company

Contractor

Grid Pool


990 Ft. from N. Line

 Ft. from S. Line

990 Ft. from E. Line

 Ft. from W. Line

SW NE NW

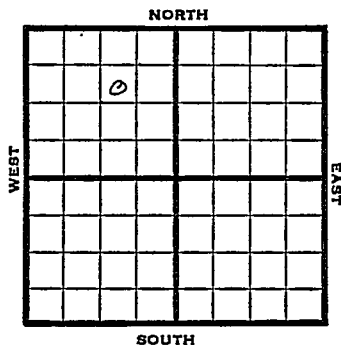

1950

Elev 1392'

REPORT

2/1

Spud 1-27-50

8"@ 136'

Drlg 1655'

2/8

TD 2767'

8"@ 136'

5"@ 2759'

Miss 2759'

P 230 BPD

Comp

COMPLETED

Kansas

Grid Pool

Map No. _____ Sec. 6 Twp. 18 R. 1W

Well No. 6 Frisbie

Westgate-Greenland

Company

Contractor

SW NE NW


SECTION PLAT

990 Ft. from N. Line

Ft. from S. Line

990 Ft. from E. Line

Ft. from W. Line

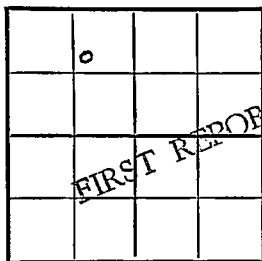

McPherson County

Location _____

Rig up _____

Drilling and Remarks:

Spud 1-27-50

8" @ 136

drlg. 1655

RECORD

Cased _____ in., _____ ft.

Sand _____

Gas _____

Oil _____

Total Depth _____

PRODUCTION

1st 24 hrs. Nat. _____

1st 24 hrs. after shot _____

Gas _____ Cu. Ft.

Dry Hole _____

Abandoned _____

Date

FEB 1 1950 19

J. E. TYRA Scout

Kansas

Map No. _____ Sec. 6 Twp. 18 R. 1WWell No. 6 FrisbieWestgate-Greenland Company

Contractor


SW NE NW

E1. 1392
SECTION PLAT990 Ft. from N. Line

_____ Ft. from S. Line

990 Ft. from E. Line

_____ Ft. from W. Line

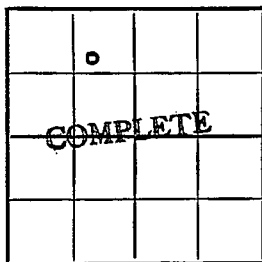

McPherson County

Location _____

Rig up _____

Drilling and Remarks:

8' @ 1365' @ 2759miss 2759P230 BOPD

RECORD

Cased _____ in., _____ ft.

Sand _____

Gas _____

Oil _____

Total Depth 2767

PRODUCTION

1st 24 hrs. Nat. _____

1st 24 hrs. after shot _____

Gas _____ Cu. Ft.

Dry Hole _____

Abandoned _____

Date

MAR 8 1950

J. E. TYRA

19

Scout