


McPherson

Section 6 Township 18 Range 1W

Well No. #7 Frisbie

Company Westgate-Greenland

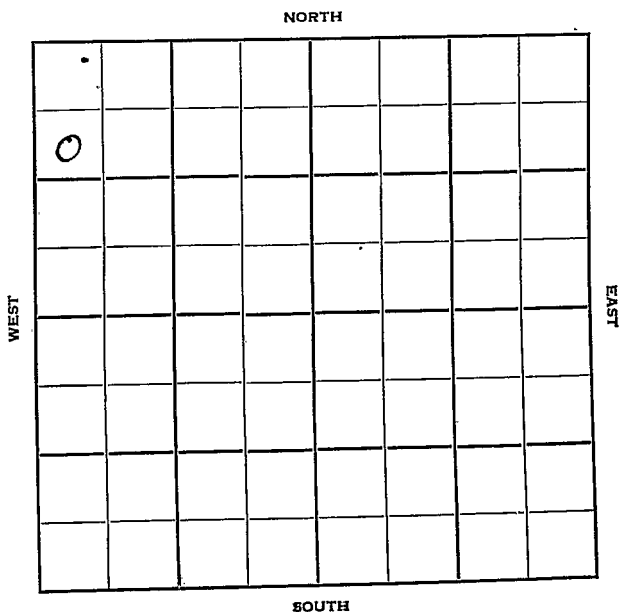

4

Sec. 6 Twp. 18 R. 1W ✓

Well No. #7 Frisbie Farm

Westgate-Greenland Company

Contractor


990' Ft. from N. Line

_____ Ft. from S. Line

_____ Ft. from E. Line

330' Ft. from W. Line

SW NW NW

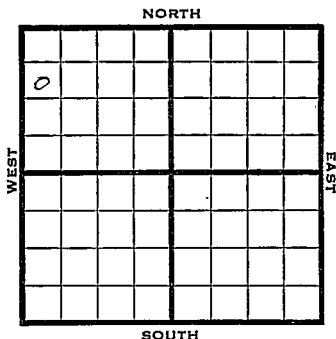

1950 Elev 1397' REPORT

2/8 Spud 2-5-50
10-3/4" @ 139'
Drlg. 375'
3/29 TD 2781'
10 3/4" @ 139'
7"@ 2780'
P 293 BOPD in Miss
Comp
COMPLETED

Kansas

Map No. _____ Sec. 6- Twp. 18 R. 1W

Well No. 7 Frisbie

Westgate-Greenland Company

Contractor

SW NW NW


SECTION PLAT

990 Ft. from N. Line

Ft. from S. Line

Ft. from E. Line

330 Ft. from W. Line

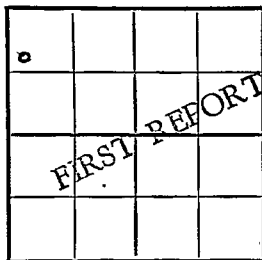

McPherson County

RECORD

Location _____

Cased _____ in., _____ ft.

Rig up _____

Sand _____

Drilling and Remarks:

Gas _____

Spud 2-5-50

Oil _____

10 3/4" @ 139

Total Depth _____

drlg. 375

PRODUCTION

1st 24 hrs. Nat. _____

1st 24 hrs. after shot _____

Gas _____ Cu. Ft.

Dry Hole _____

Abandoned _____

Date


FEB 8 1950 19

J. E. TYRA

Scout

Map No. _____ Sec. 6 Twp. 18 R. 1WWell No. 7 Frisbie_____Westgate-Greenland_____
Company_____
Contractor

SW NW NW

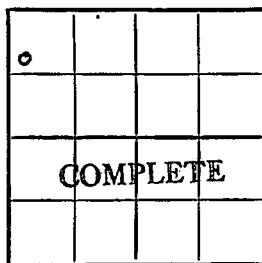E1, 1397
SECTION PLAT990
Ft. from N. Line_____
Ft. from S. Line_____
Ft. from E. Line330
Ft. from W. Line

McPherson County

Location _____

Rig up _____

Drilling and Remarks:

10 3/4 @ 1397" @ 2780P 293 BOPD
in miss.

RECORD

Cased _____ in., _____ ft.

Sand _____

Gas _____

Oil _____

Total Depth 2781

PRODUCTION

1st 24 hrs. Nat. _____

1st 24 hrs. after shot _____

Gas _____ Cu. Ft.

Dry Hole _____

Abandoned _____

Date

MAR 29 195019J. E. TYRAScout