


Section 6 Township 18 Range 1W

Well No. #8 Frisbie

Company Westgate-Greenland

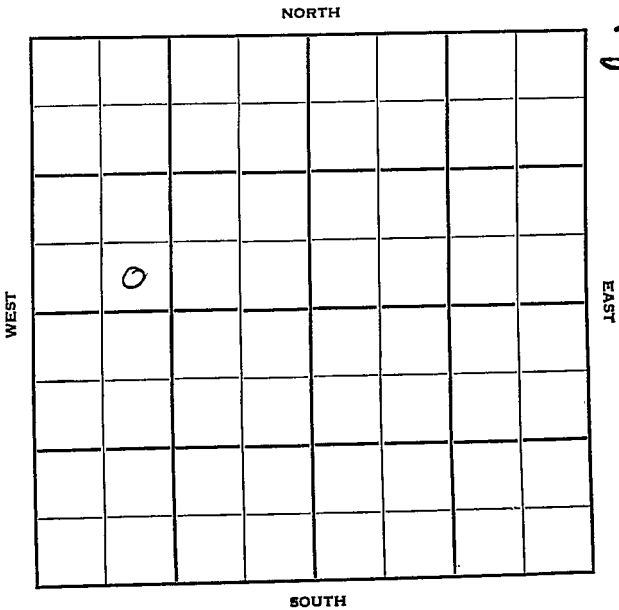

McPherson KANSAS

Sec. 6 Twp. 18 R. 1W ✓

Well No. #8 Frisbie Farm

Westgate-Greenland Company

Jackson Drlg. Contractor


           Ft. from N. Line

330' Ft. from S. Line

           Ft. from E. Line

990' Ft. from W. Line

SE SW NW

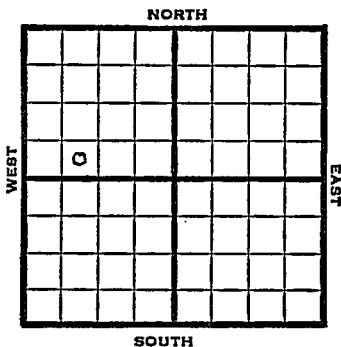

1950

Elev 1425

REPORT

6/14

Location

8/2

8" @ 147

Miss 2792-96

5" @ 2792

TD 2797

Comp 107 bopd 22% wtr

Completed

**COMPLETED**

~~Kansas~~Map No. \_\_\_\_\_ Sec. 6 Twp. 18 R. 1WWell No. 8 FrisbieWestgate-Greenland CompanyJackson Drlg. Contractor


SE SW NW

## SECTION PLAT

\_\_\_\_\_ Ft. from N. Line

330 Ft. from S. Line

\_\_\_\_\_ Ft. from E. Line

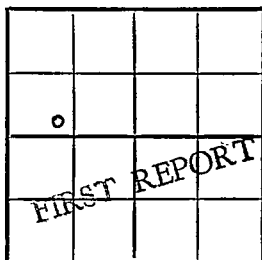990 Ft. from W. LineMcPherson CountyLocation X

Rig up \_\_\_\_\_

Drilling and Remarks:

## RECORD

Cased \_\_\_\_\_ in., \_\_\_\_\_ ft.

Sand \_\_\_\_\_

Gas \_\_\_\_\_

Oil \_\_\_\_\_

Total Depth \_\_\_\_\_

## PRODUCTION

1st 24 hrs. Nat. \_\_\_\_\_

1st 24 hrs. after shot \_\_\_\_\_


Gas \_\_\_\_\_ Cu. Ft.

Dry Hole \_\_\_\_\_

Abandoned \_\_\_\_\_

Date

JUN 14 1950 19 J. E. TYRA Scout

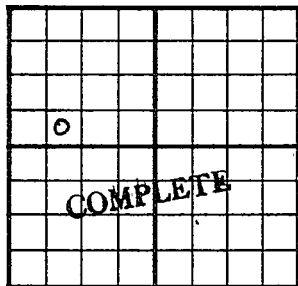County McPherson State KansasSec. 6 (<sup>Blk.</sup><sub>Twp.</sub>) 18 (<sup>Sur.</sup><sub>Rge.</sub>) 1W Map No.Operator Westgate-GreenlandWell No. 8 Farm FrisbieElev. 1425 Location SE SW NW330 Ft. From S Line NW990 Ft. From W Line Quarter1st. ReportCompletion AUG 2 1950RemarksSpudding DateDrlg. Data8" @ 147 Miss. 2792-96 5" @ 2792TD 2797 Comp. 107 hpd 22% water

J. E. TYRA