

KANSAS

McPherson County

FORM 51 IOM 12-46 PETROL

Section 6 Township 18 Range 1-W

Well No. 1 Hoffsommer


Company Mallard Drlg. et al

Paden Pool

NORTH

WEST

EAST

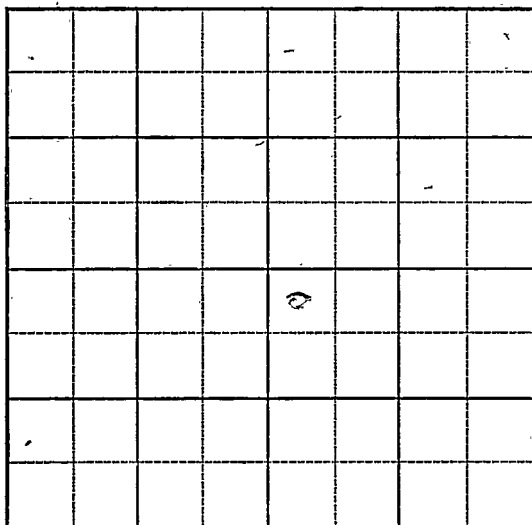

SOUTH

KANSAS

McPherson County

Sec. 6 Twp. 18 R. 1W

Well No. 1 Hoffsommer Farm

Mallard Drlg. et al Company

Paden Pool


330 Ft. from N. Line

 Ft. from S. Line

 Ft. from E. Line

330 Ft. from W. Line

NW SE

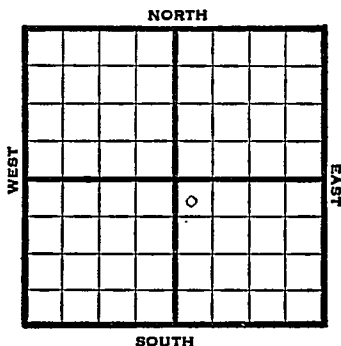

1947 El. 1396' REPORT

7-16 145 run csg.

7/22 Chat 2748'
5" @ 2800' TD
RUST

7/29 60 shots. 2752-72
1000 Acid
Swab 6 oil PH

8/6 Miss 2741'
5" @ 2800'
Perf
1000 Acid.
Pump 215 oil $\frac{1}{2}$ 24%
Gr. 36
T. D. 2800'
Complete

COMPLETED

Map No. _____ Sec. 6 Twp. 18 R. 1W

Well No. 1 Hoffsommer

Mallard D., lg. etal. Company

FIRST REPORT Contractor

NW SE


SECTION PLAT

330 Ft. from N. Line

_____ Ft. from S. Line

_____ Ft. from E. Line

330 Ft. from W. Line

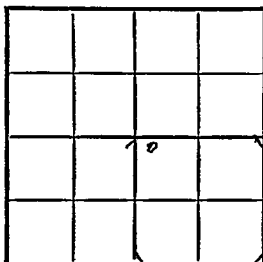

McPherson County

Location _____

Rig up _____

Drilling and Remarks:

145 run csg.

RECORD

Cased _____ in., _____ ft.

Sand _____

Gas _____

Oil _____

Total Depth _____

PRODUCTION

1st 24 hrs. Nat. _____

1st 24 hrs. after shot _____

Gas _____ Cu. Ft.

Dry Hole _____

Abandoned _____

Date

JUL 16 1947 19 S. J. LEWIS Scout

Map No. 42 Sec. 6 Twp. 18 R. 1W

Well No. 1 Hoffsommer

Mallard Drlg. etal. Company

NW SE **COMPLETE** Contractor

E11896
SECTION PLAT

330 Ft. from N. Line

 Ft. from S. Line

 Ft. from E. Line

330 Ft. from W. Line

		4	

McPherson County

Location

Rig up

Drilling and Remarks:

Miss 2741

5' to 2800

Prof.

1000000

Pump 215006 124%

36°-44

RECORD

Cased in., ft.

Sand

Gas

Oil

Total Depth 2800

PRODUCTION

1st 24 hrs. Nat.

1st 24 hrs. after shot

Gas Cu. Ft.

Dry Hole

Abandoned

Date

AUG 6 1947 19

S. J. LEWIS Scout