

KANSAS

McPherson

FORM 51 IOM 12-46 PETROL


Section 6 Township 18 Range 1-WWell No. 2 HoffsommerCompany Westgate-Greenland

Hoffsommer

NORTH

WEST

EAST

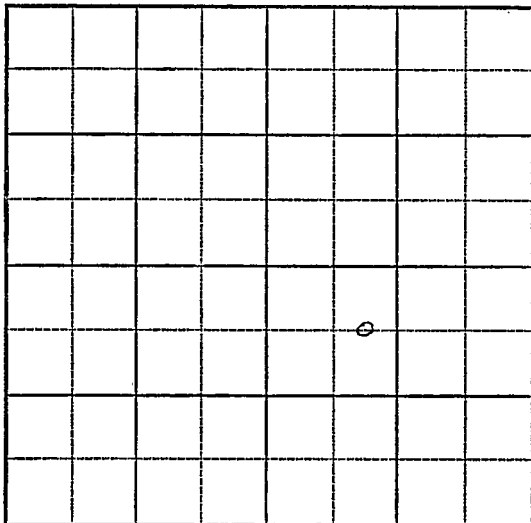

SOUTH

KANSAS

McPherson



Sec. 6 Twp. 18 R. 1W

Well No. #2 Hoffsommer Farm


Westgate-Greenland Company
Hoffsommer

660 Ft. from N. Line

 Ft. from S. Line

 Ft. from E. Line

990 Ft. from W. Line

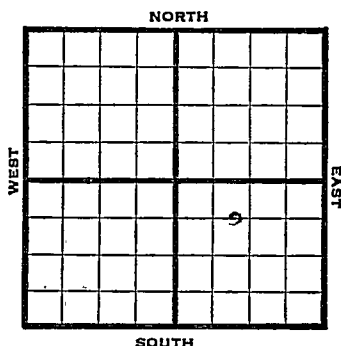

C E L NW SE

1947

REPORT

10/8 Location

10/15 "

10/22 Lansing 2160'
Mississippi 2734'
TD 2751'
5" @ 2736'
RUST

10/29 Miss. 2734'
5" @ 2739'
1000 Acid
Pump 446 Pot
TD 2756'
Gravity 38

COMPLETED

Map No. 42 Sec. 6 Twp. 18 R. 1W

Well No. 2 Hoffsommer

Westgate-Greenland Company

COMPLETE

Contractor

C E L N W S E

SECTION PLAT

660 Ft. from N. Line

_____ Ft. from S. Line

_____ Ft. from E. Line

990 Ft. from W. Line

		o	

McPherson County

Location _____

Rig up _____

Drilling and Remarks:

Miss 2784

5' @ 2789

1000 @ 2810

Prod 446 Bbl

2800

RECORD

Cased _____ in., _____ ft.

Sand _____

Gas _____

Oil _____

Total Depth 2756

PRODUCTION

1st 24 hrs. Nat. _____

1st 24 hrs. after shot _____

Gas _____ Cu. Ft.

Dry Hole _____

Abandoned _____

Date

OCT 29 1947

19

S. I. LEWIS

Scout

Map No. _____ Sec. 6 Twp. 18 R. 1W

Well No. 2 Hoffsommer

Westgate-Greenland Company

FIRST REPORT

Contractor

C E L NTH SE


SECTION PLAT

660 Ft. from N. Line

_____ Ft. from S. Line

_____ Ft. from E. Line

990 Ft. from W. Line

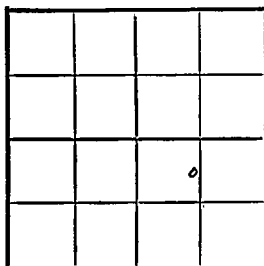

McPherson County

Location X

Rig up _____

Drilling and Remarks:

RECORD

Cased _____ in., _____ ft.

Sand _____

Gas _____

Oil _____

Total Depth _____

PRODUCTION

1st 24 hrs. Nat. _____

1st 24 hrs. after shot _____

Gas _____ Cu. Ft.

Dry Hole _____

Abandoned _____

Date

OCT 8 1947 19 S. J. LEWIS Scout