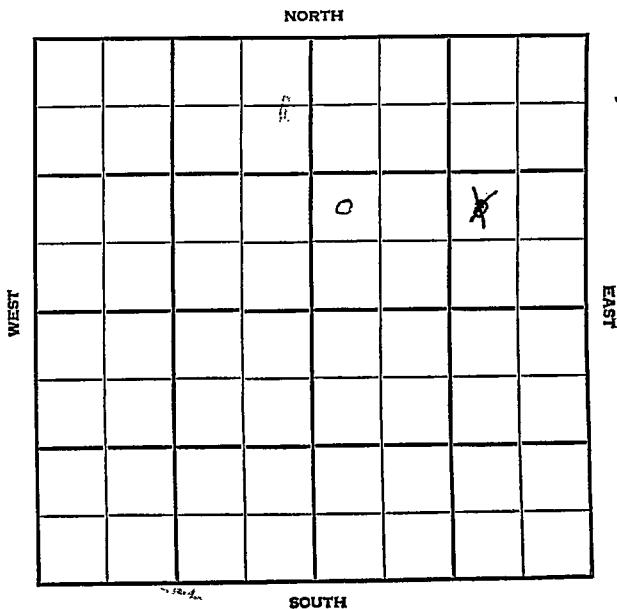


Section 6 Township 18 Range 1WWell No. #1 KoehnCompany B & R Drlg.

McPherson

KANSAS

SEC.	TWP.	R.
6	18	1 W

WELL NO.

1 Koehn

FARM

COMPANY

B & R Drlg.

CONTRACTOR

Co. tools


Georob Pool

Ft. from N. Line

990 Ft. from S. Line

~~990~~ Ft. from E. Line

330 Ft. from W. Line

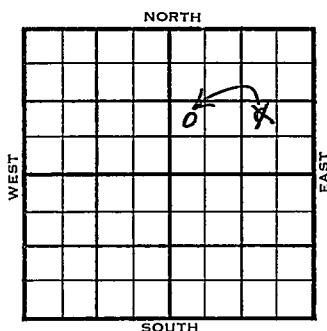NW ^{SW} SE NE

1954

ELEVATION

1396'

REPORT

12/15

Spud 12-11-54

8" @ 166

Drlg. 2110'

12/29

Spud 12-11-54

D & A

TD 2807'

8" @ 166'

Miss 2766'

TD 2807'

5" @ 2806'

CO to 2800


24/ 2782'-88' S/ 23 bwph CO to 2780

20/ 2768'-73' S/ 18 bwph 10 hr.

D & A

ABANDONED

County McPherson State Kansas
 Sec. 6 (Blk. 18 (Sur. 1W Map No. 1)
 Operator B & R Drlg.
 Well No. 1 Farm Koehn
 Elev. 1396 Location NW SW NE

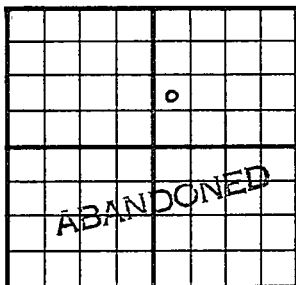

990 Ft. From S Line NE
330 Ft. From W Line Quarter

1st. Report

Completion DEC 29 1954

Remarks Georob Pool

Co. tools

Spudding Date 12-11-54

Drlg. Data D & A TD 2807

8" @ 166 Miss. 2766 TD 2807

5" @ 2806 CO to 2800 24/ 2782-88

S/ 23 bwph CO to 2780 20/ 2768-73

S/ 18 bwph 10 hr.

D & A

FABEN CU STRAP

Nadess

Map No. _____ Sec. 6 Twp. 18 R. 1WWell No. 1 Koehn

B & R Drlg. _____ Company

CORRECTION _____ Contractor

NW SW NE

SECTION PLAT

		o	

_____ Ft. from N. Line

990 Ft. from S. Line

_____ Ft. from E. Line

330 Ft. from W. Line

McPherson County

Location _____

Rig up _____

Drilling and Remarks:

Reported

NW SE NE

RECORD

Cased _____ in., _____ ft.

Sand _____

Gas _____

Oil _____

Total Depth _____

PRODUCTION

1st 24 hrs. Nat. _____

1st 24 hrs. after shot _____

Gas _____ Cu. Ft.

Dry Hole _____

Abandoned _____

Date

DEC 22 1954 19

FABEN GILSTRAP
Scout