


Section 7 Township 18 Range 1W

Well No. 1 Burk

Company Westgate-Greenland & Mallard

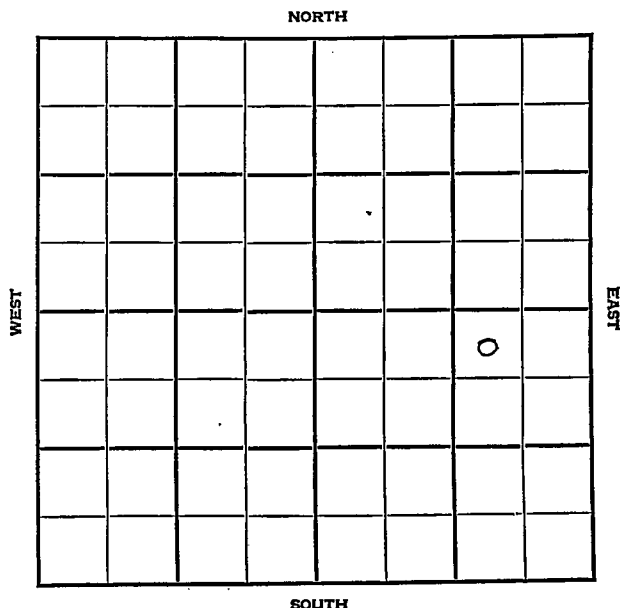

KANSAS McPherson

Sec. 7 Twp. 18 R. 1W

Well No. #1 Burk Farm
Westgate-Greenland & Mallard Company


Wildcat

330 Ft. from N. Line

 Ft. from S. Line

990 Ft. from E. Line

 Ft. from W. Line

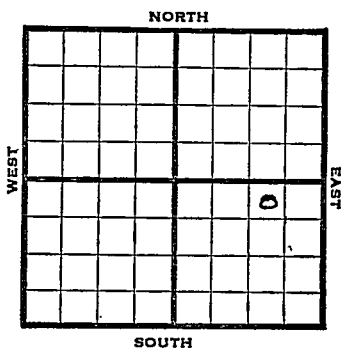

NW NE SE

1947 Elev. 1423' REPORT

12/30 10" @ 137'
Drlg. 298'

1948
1/7 Miss. 2736-42' TD
7" @ 2736'
RUST

1/14 "

1/21 TD 2784'
500' oil / 75' W in 12 hrs.

1/28 Miss. 2736'
7" @ 2736'
1000 acid
Pump 169 oil / 18% W pot.
38.0 Gr.
TD 2784'
Comp.

COMPLETED

Map No. _____ Sec. 7 Twp. 18 R. 1W

Well No. 1 Burk


Westgate-Greenland & Mallard Company

FIRST REPORT

Contractor _____

NW NE SE

SECTION PLAT

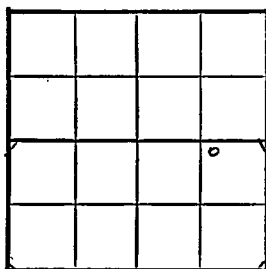

330 Ft. from N. Line

_____ Ft. from S. Line

990 Ft. from E. Line

_____ Ft. from W. Line

McPherson County

Location _____

Rig up _____

Drilling and Remarks:

10" @ 137

drlg. 298

RECORD

Cased _____ in., _____ ft.

Sand _____

Gas _____

Oil _____

Total Depth _____

PRODUCTION

1st 24 hrs. Nat. _____

1st 24 hrs. after shot _____

Gas _____ Cu. Ft.

Dry Hole _____

Abandoned _____

Date

DEC 30 1947 19

S. J. LEWIS Scout

Map No. 42 Sec. 7 Twp. 18 R. 1W

Well No. 1 Burk

Westgate-Greenland & Mallard Company

COMPLETE

Contractor

NW NE SE

E11423


SECTION PLAT

330 Ft. from N. Line

 Ft. from S. Line

990 Ft. from E. Line

 Ft. from W. Line

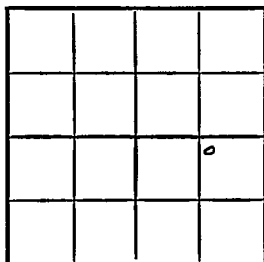

McPherson County

Location

Rig up

Drilling and Remarks:

*Miss 2736
7" @ 2736
1000 cu ft
Pump 169 oil + 180
W.B.D.*

38 3/4

RECORD

Cased in., ft.

Sand

Gas

Oil ✓

Total Depth 2784

PRODUCTION

1st 24 hrs. Nat.

1st 24 hrs. after shot

Gas Cu. Ft.

Dry Hole

Abandoned

Date

JAN 28 1949

S. J. LEWIS

Scout