



Section 7 Township 18 Range 1WWell No. #1 CraneCompany Westgate-Greenland & Mallard

NORTH

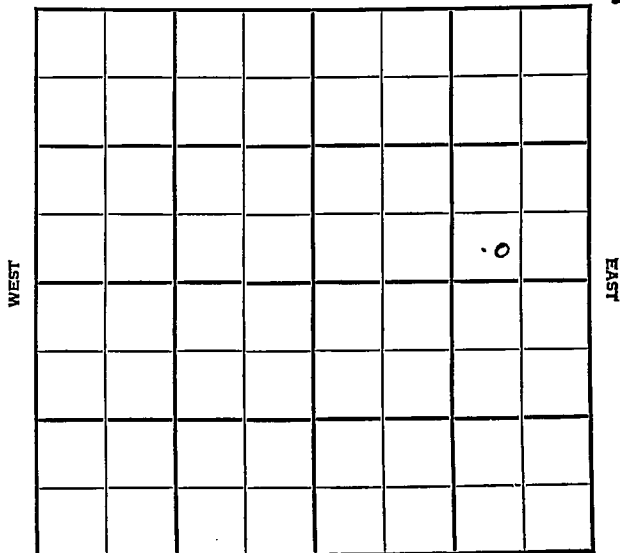

KANSAS

McPherson ✓

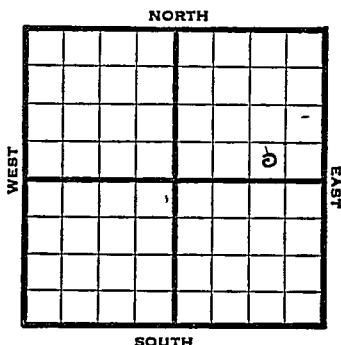Sec. 7 Twp. 18 R. 1WWell No. #1 Crane FarmWestgate-Greenland & Mallard Company
Jirod Ft. from N. Line330 Ft. from S. Line990 Ft. from E. Line Ft. from W. Line

SW SE NE

1948

Elev. 1415' REPORT

1/28 Surface hole.

2/4 10" @ 140'
Drlg. 2650'2/11 Mississippi 2727'
Hunton 3142'
Viola 3281'
Simpson 3369-88' TD
5" @ 3304'
RUST2/18 "
2/25 Perf Viola water
36 shots 2752-75
1000 acid

1000' of oil & 1000' water, 12 hrs.

3/3 "

3/10 Miss. 2727'
Viola 3281'
Simp. 3369'
5" @ 3336'
Perf. Miss
1000 Acid
Pump 256 oil & 45% W Pot.
Gr. 36°
TD 3388'**COMPLETED**


Map No. _____ Sec. 7 Twp. 18 R. 1WWell No. 1 CraneWestgate-Greenland & Malla Company

FIRST REPORT

Contractor

SW SE NE

SECTION PLAT

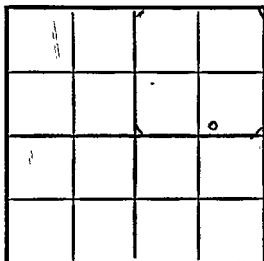

_____ Ft. from N. Line

330 Ft. from S. Line900 Ft. from E. Line

_____ Ft. from W. Line

McPherson County

Location _____

Rig up _____

Drilling and Remarks:

surface hole

RECORD

Cased _____ in., _____ ft.

Sand _____

Gas _____

Oil _____

Total Depth _____

PRODUCTION

1st 24 hrs. Nat. _____

1st 24 hrs. after shot _____

Gas _____ Cu. Ft.

Dry Hole _____

Abandoned _____

Date

JAN 28 194819S. J. LEWIS

Scout

Map No. 42 Sec. 7 Twp. 18 R. 1W

Well No. 1 Crane

Westgate-Greenland & Mallard Company

COMPLETE

Contractor

SW SE NE

E. 1415
SECTION PLAT

			0

 Ft. from N. Line

330 Ft. from S. Line

900 Ft. from E. Line

 Ft. from W. Line

McPherson County

Location

Rig up

Drilling and Remarks:

Mis 2727
Wla 3281
Sing 3368
5" C 3386

Perf Mis
1000000

Pump 256 oil + 45%

Date

26-9-44

RECORD

Cased in., ft.

Sand

Gas

Oil ✓

Total Depth 3398

PRODUCTION

1st 24 hrs. Nat.

1st 24 hrs. after shot

Gas Cu. Ft.

Dry Hole

Abandoned

MAR 10 1948

19

S. J. LEWIS

Scout