

Section 8 Township 18 Range 1WWell No. #1 KirbyCompany Ash-Mur Drlg.

NORTH

							0

SOUTH

WEST EAST

8

McPherson

KANSAS ✓

Sec. 8 Twp. 18 R. 1 W

Well No. # 1 Kirby Farm

Ash-Mur Drlg. Company

Ash-Mur Drlg. Contractor


Wildcat

 Ft. from N. Line

330 Ft. from S. Line

330 Ft. from E. Line

 Ft. from W. Line

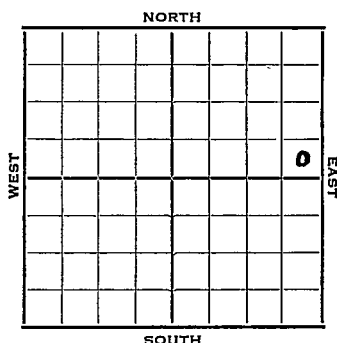

SE SE NE

Amerada - DHM

1952

Elev. 1417'

REPORT

9/24

MIR

10/1

Spud 9-21-52

D & A TD 2797' 8" @ 145

Cong. 2738' Miss 2747'

TD 2797' D & A

ABANDONED

County **McPherson** State **Kansas**

Sec. 8 (Blk.) 18 (Sur.) 1W Map No.

Operator Ash-Mur Drig.

Well No. 1 Farm Kirby

Elev.	Location	SE SE NE
-------	----------	----------

FIRST REPORT 0

330 Ft. From S Line NE

330 Ft. From E Line Quarter

1st. Report SEP 24 1952

Completion

Remarks Amerada - DEM


Ash-Mur - Contr.

Spudding Date _____

Drig. Data Wildcat

MIR

County McPherson State Kansas
 Sec. 8 (Blk.
Twp.) 18 (Sur.
Rge.) 1W Map No.
 Operator Ash-Mur Drlg.
 Well No. 1 Farm Kirby
 Elev. 1417 Location SE SE NE

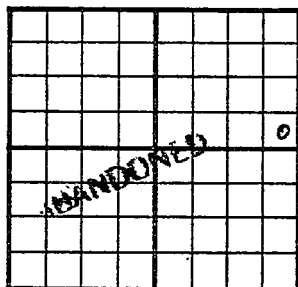

330 Ft. From S Line NE

330 Ft. From E Line Quarter

1st. Report

Completion OCT 1 1952

Remarks Wildcat

Ash - Mur - Contr.

Spudding Date 9-21-52

Drlg. Data D & A TD 2797

8" @ 145 Cong. 2738 Miss. 2747

TD 2797

D & A